

LABOR AND MATERIALS


1	Copper Lead	} Connection	3/4		\$ 1.79
1	Curb	} Clock Valve	3/4	in.	\$ 2.61
		} I. S. & V.			
1	Service box	} Short 3 1/2 X 4 1/2 Long 4 1/2 X 5 1/2 Buff or Rdway			\$ 1.82
	Old returned				
26	Ft.	} Copper Galv. Iron Cast Iron	3/4	in.	Pipe at 23 \$ 5.98
	Nipples			in. at	\$
	Bushings			to in. at	\$
	Red'g Inc'g	} Couplings		to in. at	\$
	Union			in. at	\$
	Meter			in. at	\$
	Lead Joints at				\$
	Compound Joints at				\$
	Hrs. Foreman at				\$
	Hrs. Chauffeur at				\$
2	Hrs. Tapper at		8 1/2		\$ 1.65
2	Hrs. Labor at				\$ 1.43
	Hrs. Labor at				\$
	Hrs. Compressor at				\$
	Compensation Ins.				\$.08
	Trucking				\$ 1.00
	Builders Use of Water				\$
	<i>Tap by McGuire</i>				\$
					\$
					\$
					\$
					\$ 16.36

66-7-96

St. *West*
Pl. *148*
Ave. No. *148*

Name of Owner *Bull*

Labor and Mat'l. Report *Nov 8* 19*46*

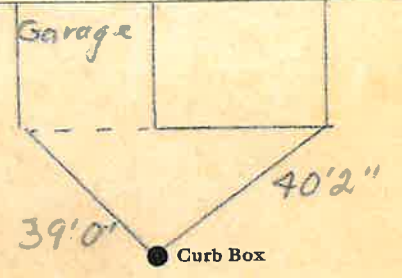

6 Main Elev. of Main at tap *4*

Gate at ● ● Gate at

● Curb Box