

LABOR AND MATERIALS

1	Copper	Connection	3/4	\$	2.87
1	Lead	Cock Valve	3/4 in.	\$	3.62
1	Service box	Short 3 1/2 X 4 1/2		\$	4.68
1	Old returned	Long 4 1/2 X 5 1/2		\$	
		Buffer Rdway		\$	
9	Ft. 3/4 in.	Copper Pipe at	32	\$	2.88
		G. I.		\$	
		C. I.		\$	
	Nipples	in. at		\$	
	Bushings	to in. at		\$	
	Red'g			\$	
	Inc'g	Coupl'gs. to in. at		\$	
	Union	in. at		\$	
	Meter	in. at		\$	
	Lead Joints	at		\$	
	Compound Joints	at		\$	
	Hrs. Water Maint. Man-1	at		\$	
3	Hrs. Water Maint. Man-2	at 1.02		\$	3.06
1	Hrs. Labor	at 91		\$	91
	Hrs. Labor	at		\$	
	Hrs. Compressor	at		\$	
	Compensation Ins.	at \$2.18 per C.		\$.06
	Trucking			\$	2.00
	Pav't Patch			\$	
	Tap 4	Magnum		\$	
	O'head			\$	
				\$	20.08


16

St. _____
 Pl. _____
 Ave. No. 151

Name of Owner _____

Ball

Labor and Mat'l. Report Sept 13 19 49

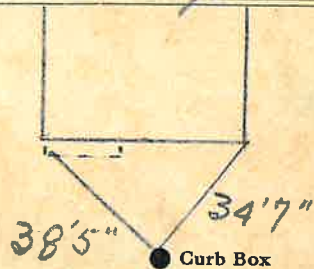

6 Main Elev. of Main at tap 4
 Gate at ● ● Gate at

● Curb Box