

LABOR AND MATERIALS

1. Copper	Connection	3/4"		\$ 2.87
1. Lead				
1. Curb	Cock	3/4" in.		\$ 3.67
	Valve			
	T. S. & V.			
1. Service box	Short	3/4" X 4 1/2"		\$ 4.68
Old returned	Long	1 1/2" X 5 1/2"		
	Buff or Rdway			
9. Ft.	3/4" in.	Copper	Pipe at	32 \$ 8.96
		G. I.		
		C. I.		
	Nipples	in. at		\$
	Bushings	to in. at		\$
	Red'g			
	Inc'g	Coupl'gs to in. at		\$
	Union	in. at		\$
	Meter	in. at		\$
	Lead Joints	at		\$
	Compound Joints	at		\$
	Hrs. Water Maint. Man-1	at		\$
4 1/2	Hrs. Water Maint. Man-2	at 1.07		\$ 4.59
	Hrs. Labor-	at 1.1		\$ 1.1
	Hrs. Labor-	at		\$
	Hrs. Compressor	at		\$
	Compensation Ins.	at \$ 2.18 per C		\$ 12
	Trucking			\$ 2.00
	Pav't Patch			\$
	Twp. by 1942 man			\$
	O'head			\$
				\$ 27.75

97

St.
Pr
Ave. No. 153


Hawley

Name of Owner

Bill

Labor and Mat'l. Report

Sept 13 19 49

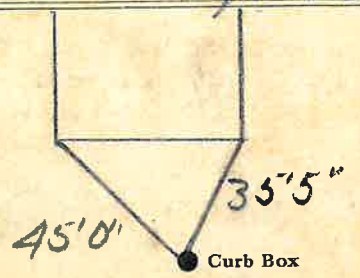

6

Gate at ●

9

Elev. of Main at tap

Gate at ●

● Curb Box