

### LABOR AND MATERIALS

Copper	Connection	3/4		\$ 2.87
Lead				3.62
Curb	Cock			
	Valve			
	T. S. & V.			
Service box	Short 3 1/2 X 4 1/2			
Old returned	Long 4 1/2 X 5 1/2			4.68
	Buff or Rdway			
28 Ft.	Copper			
in.	G. I.			
	C. I.			
	Pipe at	32		9.96
Nipples	in. at			
Bushings	to in. at			
Red'g				
Inc'g	Coupl'gs to in. at			
Union	in. at			
Meter	in. at			
Lead Joints	at			
Compound Joints	at			
Hrs. Water Maint. Man-1	at			
4 1/2	Hrs. Water Maint. Man-2	10 1/2		4.59
1	Hrs. Labor	9 1/2		9.1
	Hrs. Labor			
	Hrs. Compressor			
	Compensation Ins. at \$ 2.18 per C			12
	Trucking			2.00
	Pav't Patch			
	O'head			
				\$ 27.75


17

St. 156  
-Pl-  
Ave. No. 754

Humber

Name of Owner  
Ball

Labor and Mat'l. Report Sept 13 1949

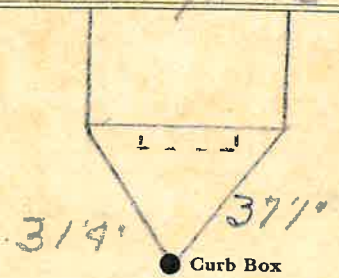

6" Main Elev. of Main at tap 4'

Gate at ● ● Gate at

N

● Curb Box