

**Labor and Materials**


1	Copper	} Connection <sup>3/4"</sup>	.....	\$. 1.25
1	Lead			
1	Curb	} Cock Valve T.S.&V. } <sup>3/4"</sup> in	.....	\$. 1.70
1	Service Box			
	Old returned	} Short 3 1/2 x 4 1/2 } Long 4 1/2 x 5 1/2 } Buff. or Rdway. }	.....	\$. 1.37
16	Ft. <sup>3/4"</sup> in.			
		} Copper Galv. Iron } Cast Iron }	Pipe at <sup>1 1/2"</sup>	\$. 2.16
	Nipples			
	in. at			
1	Bushings <sup>3/4"</sup>	to <sup>1 1/2"</sup> in. at	.....	\$. 0.5
	Red'g Inc'g	} Couplings.....to.....in.at	.....	\$. .....
	Union	in. at	.....	\$. .....
	Meter	in. at	.....	\$. .....
	Lbs. Br. Stone	at	.....	\$. .....
	Lbs. Sand	at	.....	\$. .....
	Bags Cement	at	.....	\$. .....
	Paving Brick	} Mack Red Asphalt }	at	.....
	Lead Joints			
	Leadite Joints	at	.....	\$. .....
6	Hrs. Foreman	at <sup>6 1/2</sup>	.....	\$. 3.75
3	Hrs. Common Labor	at <sup>50</sup>	.....	\$. 1.50
9	Hrs. Common Labor	at <sup>45</sup>	.....	\$. 4.05
	Hrs. Mason	at	.....	\$. .....
	Hrs. Masons Helper	at	.....	\$. .....
	Hrs. Compressor	at	.....	\$. .....
	Compensation Ins	.....		\$. 0.5
	Trucking	.....		\$. 1.-
	Builders Use of Water	.....		\$. .....

Total \$ 16.18

1935-38

Labor and Material Report <sup>17</sup> <sub>Apr 15</sub> 1935

3/4 tap at 15 Hunter st

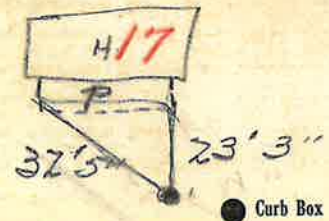

● Curb Box

4" Main

Elev. of Main at tap <sup>4 1/2</sup>

Gate at ●

● Gate at

● Curb Box

Old tap shut off at main

*(Handwritten initials/signature)*