

LABOR AND MATERIALS

Copper	} Connection		\$	
Lead				
Curb	} Cock Valve T. S. & V.	in.	\$	
Service box		} Short 3½ x 4½ Long 4½ x 5½ Buff or Rdway		\$
Old returned				
11 Ft. ¾ in.	} Copper G.I. C.I.	Pipe at	\$	
Nipples		in. at	\$	
Bushings	to	in. at	\$	
Red'g	} Coupl'gs	to	in. at	
Inc'g				
Union	in. at		\$	
Meter	in. at		\$	
Lead Joints	at		\$	
Compound Joints	at		\$	
Maintenance Foreman			\$	
Hrs. Water Maint. Man-1	at		\$	
Hrs. Water Maint. Man-2	at		\$	
Hrs. Garage Foreman	at		\$	
Hrs. Labor	at		\$	
Hrs. Compressor	at		\$	
Compensation Ins. at \$	per C		\$	
Trucking			\$	
Pav't Patch			\$	
			\$	
			\$	
O'head			\$	
			\$	

St. 21  
-Pl. 4-B  
Ave. No. 4-B

21A B HUNTER


Name of Owner

JOE MCGUIRK

Labor and Mat'l. Report

19

*M. L. Hunter*  
*for 21-B*

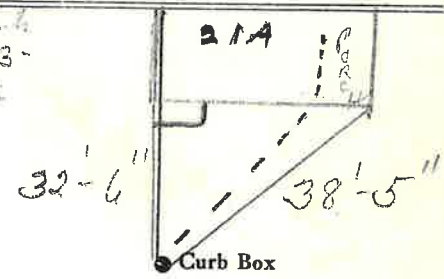

Main Elev. of Main at tap  
Gate at • Gate at

• Curb Box

Labor and Materials

1	Copper	} Connection $\frac{3}{4}$ "	.....	\$ 1.25
1	Lead		.....	
1	Curb	} Cock Valve T.S.&V. } $\frac{3}{4}$ " in	.....	\$ 1.70
1	Service Box		} Short $3\frac{1}{2} \times 4\frac{1}{2}$ Long $4\frac{1}{2} \times 5\frac{1}{2}$ Old returned Buff, or Rdway	.....
1	3 Ft. $\frac{3}{4}$ " in.	} Copper Galv. Iron Cast Iron } Pipe at 12 1/2¢		.....
	Nipples		..... in. at	.....
1	Bushings	$\frac{3}{4}$ " to $\frac{1}{2}$ " in. at	.....	\$ .05
	Red'g Inc'g	} Couplings.....to.....in.at	.....	\$
	Union		.....in. at	.....
	Meter	.....in. at	.....	\$
	Lbs. Br. Stone	at	.....	\$
	Lbs. Sand	at	.....	\$
	Bags Cement	at	.....	\$
	Paving Brick	} Mack Red Asphalt } at	.....	\$
	Lead Joints		at	.....
	Leadite Joints	at	.....	\$
5	Hrs. Foreman	at $62\frac{1}{2}$ ¢	.....	\$ 3.13
1	Hrs. Common Labor	at 50¢	.....	\$ .50
5	Hrs. Common Labor	at 45¢	.....	\$ 2.25
	Hrs. Mason	at	.....	\$
	Hrs. Masons Helper	at	.....	\$
	Hrs. Compressor	at	.....	\$
	Compensation Ins	.....	.....	\$ .77
	Trucking	.....	.....	\$ 1.-
	Builders Use of Water	.....	.....	\$

Total \$13.23

1935-40

Labor and Material Report Apr 15 1935

$\frac{3}{4}$ " tap at 19 Hunter st



4" Main

Elev. of Main at tap  $4\frac{1}{2}$

Gate at ●

● Gate at

● Curb Box

Old tap shut off at main

G/K

D/M