

**Labor and Materials**

1	Copper	Connection	3/4"	\$ 2.60
	Lead			
1	Curb	Cock Valve	3/4" in.	\$ 2.27
		T-S & V.		
1	Service Box	Short	3/4" x 4 1/2"	\$ 1.38
	Old returned	Long	4 1/2" x 5 1/2"	
		Buff- or Rdway		
1.9	Ft.	Copper	Pipe at	\$ 3.42
		Galv-iron		
		Cnst-iron		
	Nipples	in. at		\$
	Bushings	to in. at		\$
	Red'g Inc'g	Couplings	to in. at	\$
	Union	in. at		\$
	Meter	in. at		\$
	Lbs. Br. Stone	at		\$
	Lbs. Sand	at		\$
	Bags Cement	at		\$
	Paving Brick	Mack Red Asphalt	at	\$
	Lead Joints	at		\$
	Leadite Joints	at		\$
1.5	Hrs.	Foreman	at	\$ 9.38
6	Hrs.	Common Labor	at 50	\$ 3.00
6	Hrs.	Common Labor	at 45	\$ 2.70
	Hrs.	Mason	at	\$
	Hrs.	Mason's Helper	at	\$
	Hrs.	Compressor	at	\$
	Compensation	Ins		\$ 46
	Trucking			\$ 1.00
	Builders' Use of Water			\$
Total \$				26.21

31-43


24

Labor and Material Report

May 6

1931

3/4" tap at 18 Hunter

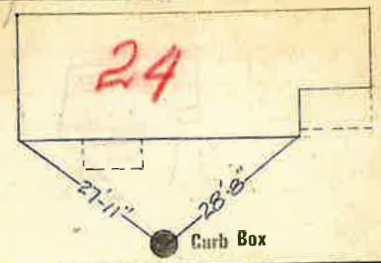

4" Main

Elev of Main at tap 50

Gate at ●

● Gate at

● Curb Box

Old tap, shut off

27' 11" 28' 8"