

Labor and Materials


| | | | |
|-------|--|-----------------------------|----------|
| 1 | Copper } Connection $\frac{3}{4}$ | | \$ 3.20 |
| | Lead | | |
| 1 | Curb } Cock | | \$ 1.00 |
| | Valve | | |
| | F.S.S.V. } $\frac{3}{4}$ in. | | |
| 1 | Service Box } Short $3\frac{1}{2} \times 4\frac{1}{2}$ | | \$ 1.30 |
| | Old returned } Long $4\frac{1}{2} \times 5\frac{1}{2}$ | | |
| | | Buff. on Railway | |
| 11 | Pt. $\frac{3}{4}$ in. } Copper | Pipe at | \$ 2.42 |
| | | | |
| | | Galv. Iron | |
| | | Cast Iron | |
| 2 | Nipples 1 in. at | ad 1 $\frac{3}{4} \times 2$ | \$.24 |
| 1 | Bushings 1 to $\frac{3}{4}$ in. at | | \$.07 |
| | Red'g } Couplings | to..... in. at | \$ |
| | Inc'g } | | |
| | Union..... in. at | | \$ |
| | Meter..... in. at | | \$ |
| | Lbs. Br. Stone at | | \$ |
| | Lbs. Sand at | | \$ |
| | Bags Cement at | | \$ |
| | Paving Brick } Mack | at | \$ |
| | | | |
| | | Red | |
| | | Asphalt | |
| | Lead Joints at | | \$ |
| | Leadite Joints at | | \$ |
| 3 | Hrs. Foreman at | 6.25 | \$ 1.87 |
| 2 | Hrs. Common Labor at | 5.00 | \$ 1.00 |
| 4 | Hrs. Common Labor at | 4.17 | \$ 1.63 |
| | Hrs. Mason at | | \$ |
| | Hrs. Mason's Helper at | | \$ |
| | Hrs. Compressor at | | \$ |
| | Compensation Ins. | | \$.12 |
| | Trucking | | \$ 1.00 |
| | Builders' Use of Water | | \$ |
| Total | | | \$ 13.85 |

26-190

Labor and Material Report

April 13 1927

25 Hunter St.

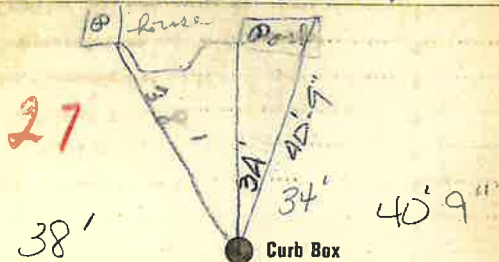

4" Main

Elev. of Main at tap $4\frac{1}{2}'$

Gate at ●

● Gate at

Old tap shut off

● Curb Box