

Labor and Materials

1	Copper } Connection	3/4"	\$	1.25
	Lead }			
1	Curb { Cock Valve T.S.&V. }	3/4" in	\$	1.70
1	Service Box { Short 3 1/2 x 4 1/2 Long 4 1/2 x 5 1/2 Buff. or Rdwax }		\$	1.37
12	Ft. 3/4" in. { Copper Galv. Iron Cast Iron } Pipe at		\$	1.76
	Nipples	in. at 1/4"	\$	
1	Bushings 3/4" to 1/2" in. at		\$.05
	Red'g Inc'g } Couplings	to in. at	\$	
	Union	in. at	\$	
	Meter	in. at	\$	
	Lbs. Br. Stone	at	\$	
	Lbs. Sand	at	\$	
	Bags Cement	at	\$	
	Paving Brick { Mack Red Asphalt }	at	\$	
	Lead Joints	at	\$	
	Leadite Joints	at	\$	
5	Hrs. Foreman	at 8 1/2 hr	\$	3.13
1	Hrs. Common Labor	at 50	\$.50
5	Hrs. Common Labor	at 45	\$	2.25
	Hrs. Mason	at	\$	
	Hrs. Masons Helper	at	\$	
	Hrs. Compressor	at	\$	
	Compensation Ins		\$.12
	Trucking		\$.1-
	Builders Use of Water		\$	


Total \$13.923

1935-43

Labor and Material Report *29* Apr 16

1936

3/4" tap at 27 Hunter at

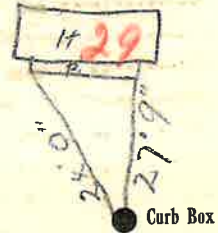

4" Main

Elev. of Main at tap 4 1/2

Gate at ●

● Gate at

● Curb Box

Old tap shut off at main

O.K. King

Disconnected at

MAIN MAR-23-1936