

# 66


**Labor and Materials**

Copper	} Connection.....	3	3	1.48
Lead				
Curb	{ Cock Valve T.S.&V. }	4	3	1.79
Service Box	{ Short 3 1/2 x 4 1/2 Long 4 1/2 x 5 1/2 Old returned { Brk. or Blwy. }	3	4	1.30
22 Ft.	in. { Copper Galv. Iron Cast Iron }	3	4	3.96
Nipples	in. at			
Bushings	to in. at			
Red'g Inc'g	} Couplings.....to.....in.at			
Union	in. at			
Meter	in. at			
Lbs. Br. Stone	at			
Lbs. Sand	at			
Bags Cement	at			
Paving Brick	{ Mack Red Asphalt }			
		at		
Lead Joints	at			
Leadite Joints	at			
3 Hrs.	Foreman at			1.88
8 Hrs.	Common Labor at			4.00
	Common Labor at			
	Mason at			
	Masons Helper at			
	Compressor at			
	Compensation Ins			1.80
	Trucking			1.00
	Builders Use of Water			5.00

Total \$ 70.59

4 32-66 32 A.B  
 Labor and Material Report June 10 1972

26-263 Helton St

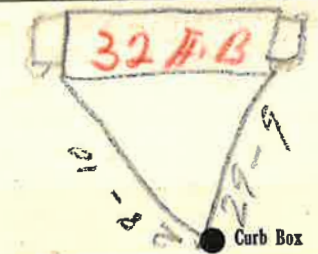

4 Main Elev. of Main at tap 5

Gate at ● Gate at ●  
 TAX ID # 302.16-13-38

● Curb Box

old Tap shut off  
 at Main

OK GMD