

LABOR AND MATERIALS

1	Copper Lead	Connection	3/4"		\$ 3.04
1	Curb	Cock Valve T.S. & V.	3/4 in.		\$ 3.54
1	Service box Old returned	Short 3 1/2 x 4 1/2 Long 4 1/2 x 5 1/2 Buff or Rdway			\$ 4.70
17	Ft.	Copper G.I. G.I.	3/4 in. Pipe at		\$ 5.95
	Nipples	in. at			\$
	Bushings	to in. at			\$
	Red'g Inc'g	Coupl'gs to in. at			\$
	Union	in. at			\$
	Meter	in. at			\$
	Lead Joints at				\$
	Compound Joints at				\$
	Hrs. Water Maint. Man-1 at				\$
	Hrs. Water Maint. Man-2 at				\$
5	Hrs. Labor	A.M. at	1.26		\$ 6.30
33	Hrs. Labor	at	1.02		\$ 33.66
	Hrs. Compressor at				\$
	Compensation Ins. at	\$ 2.66 per C.			\$ 1.06
	Trucking				\$ 1.00
	Pav't Patch				\$ 15.75
	O'head				\$
	Tap made by Gifford				\$ 75.00
	4-18-51				


39.96

LS-115 ST.

St.
PL
Ave. No. 6

Name of Owner
HUNTER
SUPREMANANT

Labor and Mat'l. Report April 18 1951

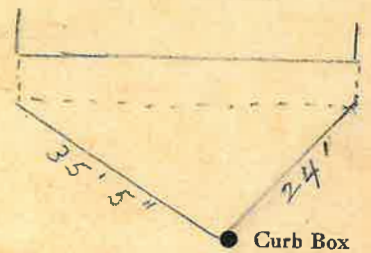

4 Main Elev. of Main at tap 5'

Gate at ● ● Gate at

TAX ID # 302.16-13-26

● Curb Box