

Labor and Materials

| | | | | |
|----|-------------------------|---|----------------------------|----------|
| 1 | Copper | } Connection ^{3/4"} | | \$. 1.25 |
| | Lead | | | |
| 1 | Curb | } Cock Valve T.S.&V. } ^{3/4"} in | | \$. 1.70 |
| | | | | |
| 1 | Service Box | } Short 3 1/2 x 4 1/2 } } Long 4 1/2 x 5 1/2 } } Old returned Buff. or R.dway } | | \$. 1.97 |
| | | | | |
| 10 | Ft. ^{3/4"} in. | } Copper Galv. Iron } } Cast Iron } | Pipe at ^{13 1/2"} | \$. 1.25 |
| | | | | |
| | Nipples | in. at | | \$. |
| | Bushings | to | in. at | \$. |
| | Red'g Inc'g | } Couplings | to | in. at |
| | | | | |
| | Union | in. at | | \$. |
| | Meter | in. at | | \$. |
| | Lbs. Br. Stone | at | | \$. |
| | Lbs. Sand | at | | \$. |
| | Bags Cement | at | | \$. |
| | Paving Brick | } Mack Red Asphalt } | at | \$. |
| | | | | |
| | Lead Joints | at | | \$. |
| | Leadite Joints | at | | \$. |
| 5 | Hrs. Foreman | at | ^{62 hr} | \$. 3.13 |
| 1 | Hrs. Common Labor | at | ⁵⁰ | \$. .50 |
| 5 | Hrs. Common Labor | at | ^{AS} | \$. 2.25 |
| | Hrs. Mason | at | | \$. |
| | Hrs. Masons Helper | at | | \$. |
| | Hrs. Compressor | at | | \$. |
| | Compensation Ins | | ²² | \$. .22 |
| | Trucking | | ¹ | \$. .10 |
| | Builders Use of Water | | | \$. |

Total \$ 12.77

1935 - 48


33

Labor and Material Report

Apr 17

1925

3/4" tap at 31 Hunter st

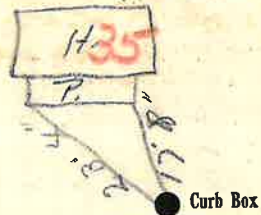

● Curb Box

^{4"} Main

Elev. of Main at tap ^{14 1/2"}

● Gate at

● Gate at

● Curb Box

Old tap shut off at main

11/6