


Labor and Materials

| | | | | |
|----------------------------|---|-----------------|-------------|--------------|
| 1..Copper | } Connection | 3/4 | | \$. 1.25 |
| 1..Lead | | | | |
| 1..Curb | } Cock Valve T.S.&V. | 3/4 in | | \$. 1.70 |
| 1..Service Box | | | | |
| Old returned | } Short 3 1/2 x 4 1/2 Long 4 1/2 x 5 1/2 Buff. or Rdway | | | \$. 1.37 |
| 24 Ft. 3/4 in. | | | | |
| | } Copper Galv. Iron Cast Iron | } Pipe at 13/16 | | \$. 2.74 |
|Nipples | | | | |
|Bushings |to |in. at | |\$ |
|Red'g Inc'g | } Couplings |to |in. at |\$ |
|Union | | | | |
|Meter |in. at | | |\$ |
|Lbs. Br. Stone | at | | |\$ |
|Lbs. Sand | at | | |\$ |
|Bags Cement | at | | |\$ |
|Paving Brick | } Mack Red Asphalt | } at | |\$ |
|Lead Joints | | | | |
|Leadite Joints | at | | |\$ |
| 7..Hrs. Foreman | at | 67.12 | | \$. 4.37 |
| 3..Hrs. Common Labor | at | 50 | | \$. 1.50 |
| 10..Hrs. Common Labor | at | 45 | | \$. 4.50 |
|Hrs. Mason | at | | |\$ |
|Hrs. Masons Helper | at | | |\$ |
|Hrs. Compressor | at | | |\$ |
|Compensation Ins | | | |\$. 39 |
|Trucking | | | |\$. 1.- |
|Builders Use of Water | | | |\$ |
| Total | | | | \$. 19.33 |

1935-A7 36 Labor and Material Report 9/1/35 1935

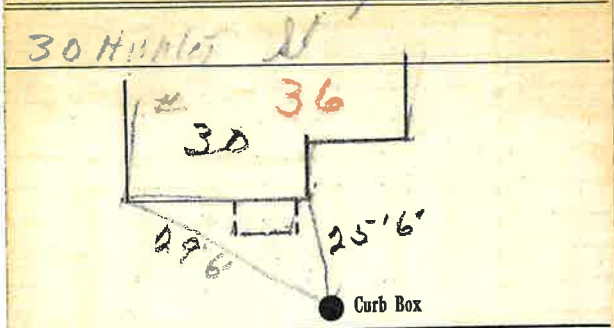

4 Main Elev. of Main at tap 4 1/2

Gate at ● Gate at ●

● Curb Box

old Street off at corner

M