


LABOR AND MATERIALS

1 Copper	} Connection	3"	\$
Lead		1/4	
1 Curb	} Cock Valve T.S. & V.	3/4 in.	\$
1 Service box		} Short 3 1/2 x 4 1/2 Long 4 1/2 x 5 1/2 Buff or Rdway	\$
- Old returned			
14 Ft. 3/4 in.	} Copper G.I. C.I.	Pipe at	\$
Nipples		in. at	\$
Bushings		to in. at	\$
Red'g	} Coupl'gs	to in. at	\$
Inc'g			\$
Union	in. at	\$	
Meter	in. at	\$	
Lead Joints	at	\$	
Compound Joints	at	\$	
Maintenance Foreman		\$	
Hrs. Water Maint. Man	1 at	\$	
Hrs. Water Maint. Man	2 at	\$	
Hrs. Garage Foreman	at	\$	
Hrs. Labor	at	\$	
Hrs. Compressor	at	\$	
Compensation Ins.	at \$ per C.	\$	
Trucking		\$	
Pav't Patch		\$	
Tap by Gifford & Co.			
11-22-60			
O'head		\$	

Hunter St. Pl. Ave. No. 7

Name of Owner Alice McPhillips

Labor and Mat'l. Report Nov. 22 1960

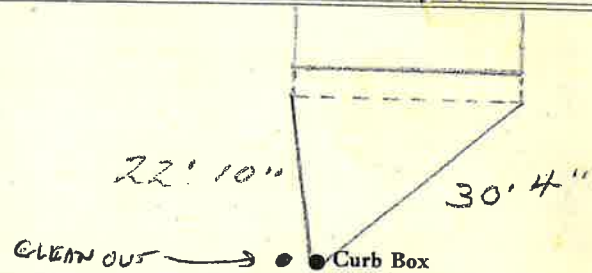

4" C.I. Main Elev. of Main at tap 5'

Gate at • Gate at

• Curb Box