

Labor and Materials

1	Copper	} Connection ^{3/4}	\$ 1.75
	Lead			
1	Curb	} ^{3/4} in	\$ 1.70
	Service Box	} Short 3 1/2 x 4 1/2	} <i>Old box</i>
	Old returned			
		Buff. or Rdway		
11	Ft. ^{3/4} in.	} Copper	} Pipe at ^{13 1/2}
		Cast Iron		
	Nipples in. at	\$
	Bushings to	in. at	\$
	Red'g	} Couplings to	in. at
	Inc'g			
	Union in. at	\$
	Meter in. at	\$
	Lbs. Br. Stone	at	\$
	Lbs. Sand	at	\$
	Bags Cement	at	\$
	Paving Brick	} Mack	} at
		Asphalt		
	Lead Joints	at	\$
	Leadite Joints	at	\$
5	Hrs. Foreman	at	^{6 1/2}	\$ ^{3.13}
1	Hrs. Common Labor	at	⁵⁰	\$
5	Hrs. Common Labor	at	^{AS}	\$ ^{2.75}
	Hrs. Mason	at	\$
	Hrs. Masons Helper	at	\$
	Hrs. Compressor	at	\$
	Compensation Ins	^{2.2}	\$
	Trucking	¹	\$
	Builders Use of Water		\$


Total \$ 11.54

1935-52

43

Labor and Material Report Apr 25 1935

3/4" tap at 37 Hunter at

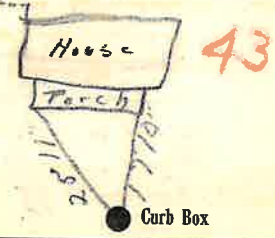

11 Main Elev. of Main at tap ^{4 1/2}

Gate at ● Gate at ●

● Curb Box
Old tap put off at main