


**Labor and Materials**

1	Copper	Connection	$\frac{3}{4}$	\$	1.25
1	Lead				
1	Curb	Cock Valve T.S.&V.	$\frac{3}{4}$ in	\$	1.70
1	Service Box	Short $3\frac{1}{2} \times 4\frac{1}{2}$		\$	1.37
	Old returned	Long $4\frac{1}{2} \times 5\frac{1}{2}$			
		Buff. or Rdway			
20	Ft. $\frac{3}{4}$ in.	Copper Galv. Iron Cast Iron	Pipe at $1\frac{3}{4}$	\$	2.70
	Nipples		in. at	\$	
1	Bushings	$\frac{3}{4}$ to $\frac{1}{2}$	in. at	\$	.05
	Red'g Inc'g	Couplings	to in. at	\$	
	Union		in. at	\$	
	Meter		in. at	\$	
	Lbs. Br. Stone		at	\$	
	Lbs. Sand		at	\$	
	Bags Cement		at	\$	
	Paving Brick	Mack Red Asphalt	at	\$	
	Lead Joints		at	\$	
	Leadite Joints		at	\$	
7	Hrs. Foreman		at $62\frac{1}{2}$	\$	4.38
3	Hrs. Common Labor		at $50$	\$	1.50
10	Hrs. Common Labor		at $45$	\$	4.50
	Hrs. Mason		at	\$	
	Hrs. Masons Helper		at	\$	
	Hrs. Compressor		at	\$	
	Compensation Ins			\$	.39
	Trucking			\$	1.-
	Builders Use of Water			\$	
				Total	\$ 18.84

1935-53  
 49A-13  
 Labor and Material Report *Apr 20* 1935

$\frac{3}{4}$  tap at 384 38 1/2 Hunter at

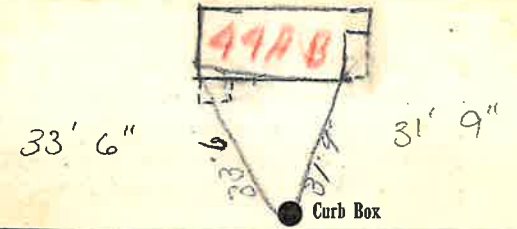

4" Main  
 Elev. of Main at tap  $4\frac{1}{2}$   
 Gate at ● Gate at ●

● Curb Box  
 Old tap shut off at main

*[Handwritten signature]*