



Labor and Materials

Copper } Connection	\$ 2.70
Lead } Connection	
Curb } Cock Valve	\$ 2.39
} T.S. & V.	
Service Box } Short 3 1/2 x 4 1/2	\$ 1.45
Old returned } Long 4 x 5 1/2	
} Buff. or Rdway	
17 Ft. in. } Copper	\$ 2.97
} Galv. Iron	
} Cast Iron	
Nipples in. at	\$
Bushings to in. at	\$
Red'g } Couplings	\$
Inc'g } to in. at	\$
Union in. at	\$
Meter in. at	\$
Lbs. Br. Stone at	\$
Lbs. Sand at	\$
Bags Cement at	\$
Paving Brick } Mack	\$
} Red	
} Asphalt	
at	\$
Lead Joints at	\$
Leadite Joints at	\$
2 Hrs. Foreman at	\$ 1.25
12 Hrs. Common Labor at	\$ 5.40
Hrs. Common Labor at	\$
Hrs. Mason at	\$
Hrs. Mason's Helper at	\$
Hrs. Compressor at	\$
Compensation Ins.	\$.21
Trucking	\$ 1.-
Builders' Use of Water Patch	\$ 5.-
Total	\$ 22.37



Galv. Iron Main
 4 Main Elev of Main at tap *5*
 Gate at ● ● Gate at

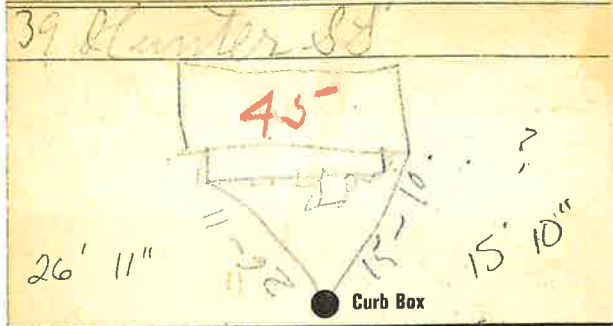

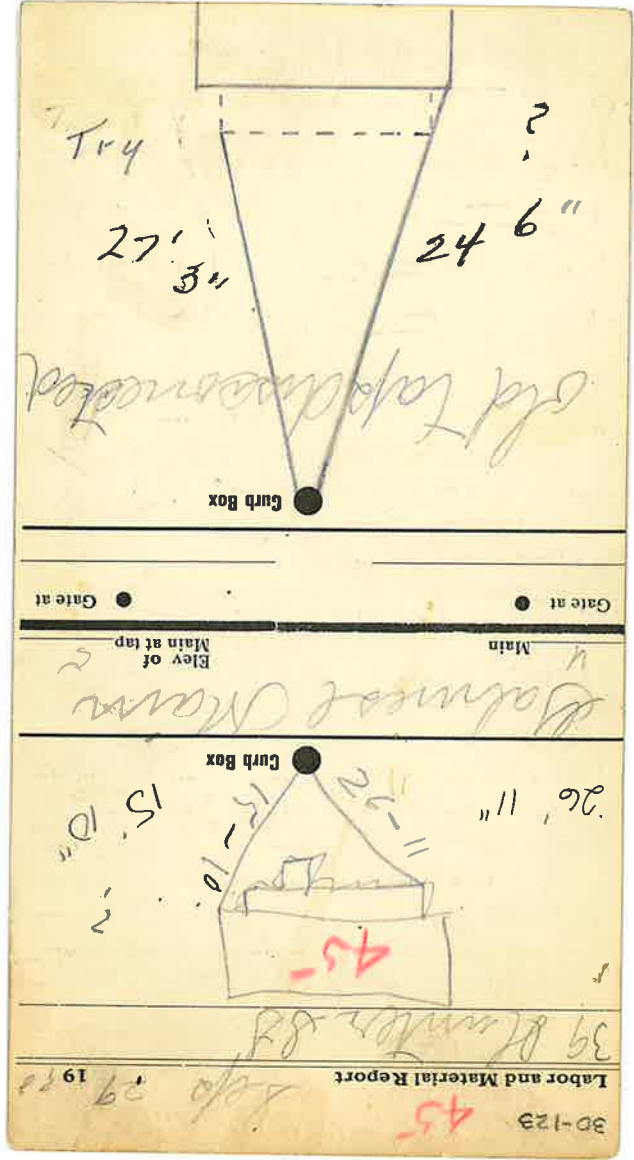

Try

27' 3"

24' 6"

?

Old Tap & Measurement

Curb Box

Gate at ● Gate at ●

Main 4
Main at tap 5
Main at Cream

Curb Box



26' 11"

15' 10"

45-

39 Plumber 88
Labor and Material Report
45
30-123
Sept 29 19