


Labor and Materials

1	Copper	Connection	3/4	\$ 1.25
1	Curb	Cock Valve T.S.&V.	3	\$ 1.70
1	Service Box	Short 3 1/2 x 4 1/2		\$ 1.37
	Old returned	Long 4 1/2 x 5 1/2		
2 1/2	Ft. 3/4 in.	Copper Galv. Iron Pipe at	1.37	\$ 3.28
	Nipples	in. at		\$
	Bushings	to in. at		\$
	Red'g Inc'g	Couplings to in. at		\$
	Union	in. at		\$
	Meter	in. at		\$
	Lbs. Br. Stone	at		\$
	Lbs. Sand	at		\$
	Bags Cement	at		\$
	Paving Brick	Mack Red Asphalt at		\$
	Lead Joints	at		\$
	Leadite Joints	at		\$
2	Hrs. Foreman	at	6.25	\$ 1.25
16	Hrs. Common Labor	at	45	\$ 7.20
	Hrs. Common Labor	at		\$
	Hrs. Mason	at		\$
	Hrs. Masons Helper	at		\$
	Hrs. Compressor	at		\$
	Compensation Ins			\$ 3.7
	Trucking			\$ 1.1
	Builders Use of Water	patch		\$ 5.0
Total				\$ 22.47

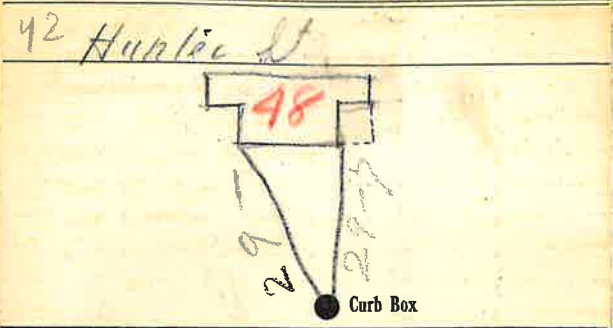

6 Main Elev. of Main at tap 5 1/2

Gate at ● Gate at ●

● Curb Box

old street off at Hunter

[Handwritten signature]