


Labor and Materials

Lead Connection		\$ 2.69
Curb Cock		\$ 1.76
Service Box	(Short 31 x 41) #2003	
Old returned	(Buffalo) NEW CURB BOX	
21' 8" cop. in. C.P. Pipe at		\$ 3.90
Nipples	in. at	\$
Bushings	to 1/2 in. at	\$ 1.07
Red'g Coup	to in. at	\$
Inc'g Coup	to in. at	\$
Union	in. at	\$
Meter	in. at	\$
Cu. Yds. Br. Stone at		\$
Cu. Yds. Sand at		\$
Bags Cement at		\$
Paving Brick	{ Mack Red Asphalt } at	\$
3 Hrs. Foreman at		\$ 4.88
1.6 Hrs. Common Labor at		\$ 6.50
Hrs. Mason at		\$
Hrs.	at	\$
Hrs.	at	\$
Builders' Use of Water		\$
Company	at	\$ 1.00
Comp. Lho	at	\$ 2.7
	at	\$
	at	\$
Total		\$ 18.02

520 Sept 20 1924
Labor and Material Report

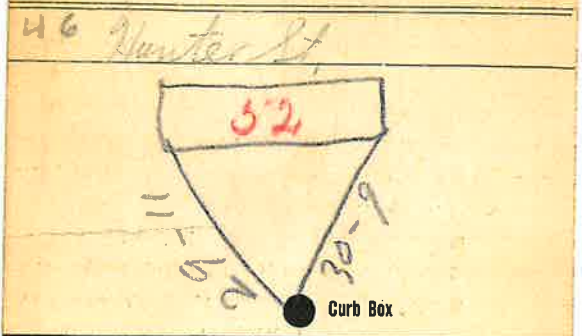

6 Main Elev. of Main at tap 45
Gate at ● Gate at ●

● Curb Box

NEW CURB BOX INSTALLED
AND NEW H₂O LINE IN 2003,
COPPER

CURB BOX IS NOW 1'7"
CLOSER TO HOUSE. KH 2003