

Labor and Materials

Copper } Connection.....	3	\$ 2.70
Lead }		
Curb } Cock Valve }	3	\$ 2.39
} T.S. & V. }		
Service Box } Short 3/4 x 1/2 }		\$ 1.45
Old returned } Long 1/2 x 3/4 }		
} Buff. or Rdway }		
1 1/2 Ft. } Copper } Pipe at.....	3	\$ 4.32
} Galv. Iron }		
} Cast Iron }		
Nipples..... in. at.....		\$
Bushings..... to..... in. at.....		\$
Red'g } Couplings..... to..... in. at.....		\$
Inc'g }		
Union..... in. at.....		\$
Meter..... in. at.....		\$
Lbs. Br. Stone at.....		\$
Lbs. Sand at.....		\$
Bags Cement at.....		\$
Paving Brick } Mack } at.....		\$
} Red }		
} Asphalt }		
Lead Joints at.....		\$
Leadite Joints at.....		\$
5 Hrs. Foreman at.....		\$ 3.13
15 Hrs. Common Labor at.....		\$ 6.75
Hrs. Common Labor at.....		\$
Hrs. Mason at.....		\$
Hrs. Mason's Helper at.....		\$
Hrs. Compressor at.....		\$
Compensation Ins.....		\$.30
Trucking.....		\$ 1.-
Builders' Use of Water..... Patch		\$ 5.-
Total \$		27.44


30-134

70

Labor and Material Report

1930

64

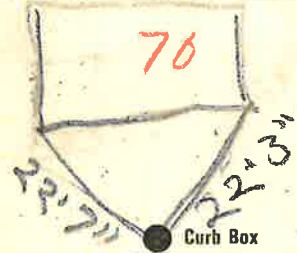

11 Main Eley of Main at tap 4

Gate at ● Gate at ●

● Curb Box

All taps disconnected