

LABOR AND MATERIALS

/	Copper Lead } Connection $\frac{3}{4}$		\$ 1.59	
/	Curb } Cock Valve T. S. & V. } $\frac{3}{4}$ in.		\$ 2.74	
/	Service Box Old returned } Short $3\frac{1}{2} \times 4\frac{1}{2}$ } Long $4\frac{1}{2} \times 5\frac{1}{2}$ } Buffer Rdway }		\$ 1.82	
14	Ft. $\frac{3}{4}$ in. } Copper Galv. Iron } Cast Iron }	Pipe at 19	\$ 2.66	
	Nipples.....	in. at	\$	
	Bushings.....	to..... in. at	\$	
	Red'g } Inc'g }	Couplings..... to..... in. at	\$	
	Union.....	in. at	\$	
	Meter.....	in. at	\$	
	Lead Joints at		\$	
	Leadite Joints at		\$	
1	Hrs. Foreman at	77	\$ 7.77	
6	Hrs. Chauffeur at	68 $\frac{3}{4}$	\$ 4.13	
2	Hrs. Tapper at		\$ 1.37	
6	Hrs. Labor at	60	\$ 3.60	
	Hrs. Labor at		\$	
1	Hrs. Compressor at	8 $\frac{1}{2}$	\$ 1.88	
	Compensation Ins.		\$ 30	
	Trucking		\$ 1-	
	Builders Use of Water		\$ 5-	
	<i>Top by Watusinski</i>			
			\$	
			\$	
			\$ 25.86	

9-45

St. 72
Pl. 66
Ave. No. 66


Hunter

Name of Owner

Lavelle

Labor and Mat'l. Report

May 21 1945

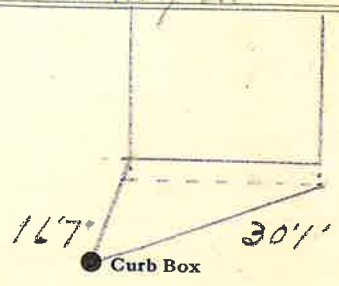

● Curb Box