


### Labor and Materials

1	Copper	Connection $3/4$	.....	\$ 1.75	
	Lead				
1	Curb	Cock Valve T.S.&V. $3/4$ in	.....	\$ 1.70	
1	Service Box	Short $3\frac{1}{2} \times 4\frac{1}{2}$	} .....	\$ 1.27	
	Old returned	Long $4\frac{1}{2} \times 5\frac{1}{2}$ Buff. or Rdway			
13	Ft. $3/4$ in.	Copper Galv. Iron Cast Iron	Pipe at $13\frac{1}{2}$	\$ 6.76	
	Nipples	..... in. at	.....	\$	
	Bushings	..... to .....	in. at	\$	
	Red'g Inc'g	Couplings	..... to .....	in. at	\$
	Union	..... in. at	.....	\$	
	Meter	..... in. at	.....	\$	
	Lbs. Br. Stone	at	.....	\$	
	Lbs. Sand	at	.....	\$	
	Bags Cement	at	.....	\$	
	Paving Brick	Mack Red Asphalt	at	\$	
	Lead Joints	at	.....	\$	
	Leadite Joints	at	.....	\$	
5	Hrs. Foreman	at	$6\frac{1}{2}$	\$ 3.13	
1	Hrs. Common Labor	at	$5\frac{1}{2}$	\$ 2.50	
5	Hrs. Common Labor	at	$4\frac{1}{2}$	\$ 2.25	
	Hrs. Mason	at	.....	\$	
	Hrs. Masons Helper	at	.....	\$	
	Hrs. Compressor	at	.....	\$	
	Compensation Ins	.....	.....	\$ 2.2	
	Trucking	.....	.....	\$ 1.00	
	Builders Use of Water	.....	.....	\$	

Total \$ 12.15

$3/4$  tap at 5 +  $5\frac{1}{2}$  Header at

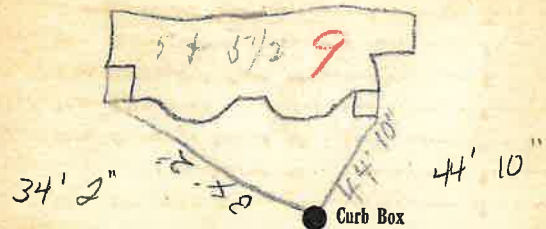

4 Main Elev. of Main at tap  $4\frac{1}{2}$

Gate at ● ● Gate at

● Curb Box

Old tap shut off at main

O.K.  
*[Signature]*

### Labor and Materials


1	Copper } Connection <sup>3/4"</sup>	.....	\$
1	Lead } .....	.....	\$
1	Curb { Cock Valve } <sup>3/4</sup> in	.....	\$
	{ T.S.&V. } .....	.....	\$
1	Service Box { Short $3\frac{1}{2} \times 4\frac{1}{2}$ } .....	.....	\$
	Old returned { Long $4\frac{1}{2} \times 5\frac{1}{2}$ } .....	.....	\$
	{ Buff. or Rdway } .....	.....	\$
1.3	Ft. <sup>3/4</sup> in. { Copper } Pipe at	.....	\$
	{ Galv. Iron } .....	.....	\$
	{ Cast Iron } .....	.....	\$
.....	Nipples ..... in. at	.....	\$
.....	Bushings ..... to ..... in. at	.....	\$
.....	Red'g } Couplings ..... to ..... in. at	.....	\$
.....	Inc'g } .....	.....	\$
.....	Union ..... in. at	.....	\$
.....	Meter ..... in. at	.....	\$
.....	Lbs. Br. Stone at	.....	\$
.....	Lbs. Sand at	.....	\$
.....	Bags Cement at	.....	\$
.....	Paving Brick { Mack } at	.....	\$
	{ Red } .....	.....	\$
	{ Asphalt } .....	.....	\$
.....	Lead Joints at	.....	\$
.....	Leadite Joints at	.....	\$
.....	Hrs. Foreman at	.....	\$
.....	Hrs. Common Labor at	.....	\$
.....	Hrs. Common Labor at	.....	\$
.....	Hrs. Mason at	.....	\$
.....	Hrs. Masons Helper at	.....	\$
.....	Hrs. Compressor at	.....	\$
.....	Compensation Ins	.....	\$
.....	Trucking	.....	\$
.....	Builders Use of Water	.....	\$
<b>Total \$</b> .....			

Labor and Material Report

Aug 29

1935

3/4" tap at 5 + 5 1/2 Hunter St.

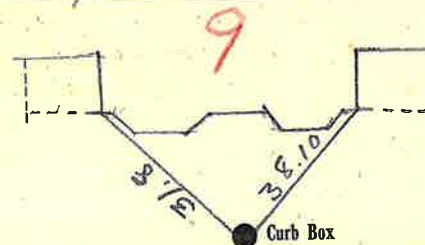

4" Main

Elev of Main at tap 4 1/2

Gate at ●

● Gate at

● Curb Box