

Labor and Materials

1	Copper } Connection	3		\$ 3.20
	Lead } $\frac{1}{4}$			
1	Curb { Cock Valve } $\frac{3}{4}$ in.			\$ 1.00
				T. S. & V.
1	Service Box { Short 3" x 4" } $\frac{1}{2}$			\$ 1.30
				Duff. or Redway
13	Ft. $\frac{3}{4}$ in. { Copper } Pipe at			\$ 2.86
				Cast Iron
	Nipples..... in. at.....			\$
	Bushings..... to..... in. at.....			\$
	Red'g } Couplings..... to..... in. at.....			\$
	Inc'g }			
	Union..... in. at.....			\$
	Meter..... in. at.....			\$
	Lbs. Br. Stone at.....			\$
	Lbs. Sand at.....			\$
	Bags Cement at.....			\$
	Paving Brick { Mack } at			\$
				Red
				Asphalt
	Lead Joints at.....			\$
	Leadite Joints at.....			\$
3	Hrs. Foreman at.....	62.5		\$ 1.87
1	Hrs. Common Labor at.....	50		\$.50
5	Hrs. Common Labor at.....	20.8		\$ 2.08
	Hrs. Mason at.....			\$
	Hrs. Mason's Helper at.....			\$
	Hrs. Compressor at.....			\$
	Compensation Ins.....			\$ 42
3	Trucking.....			\$ 1.00
3	Builders' Use of Water.....			\$
Total \$				13.88

27-8

81

Labor and Material Report

1923

71 East Hunter St



Curb Box

6 Main

Elev. of Main at tap 43

Gate at ●

● Gate at

● Curb Box

New House

LABOR AND MATERIALS

3/4 ~~Copper~~ } Connection _____ \$ _____
 Lead }
 Curb } Cock } _____ in. \$ _____
 } Valve }
 } T.S. & V. }

Service box { Short 3-1/2 x 4-1/2 } _____ \$ _____
 Old returned { Long 4-1/2 x 5-1/2 }

20 Ft. _____ in. { Copper } Pipe at _____ \$ _____
 { G.I. }
 { C.I. }


_____ Nipples _____ in. at _____ \$ _____
 _____ Bushings _____ to _____ in. at _____ \$ _____
 _____ Red'g _____
 _____ Inc'g _____
 _____ Union _____ in. at _____ \$ _____
 _____ Meter _____ in. at _____ \$ _____
 _____ \$ _____
 _____ Compound Joints at _____ \$ _____
 _____ Maintenance Foreman _____ \$ _____
 _____ Hrs. Water Maint. Man - 1 at _____ \$ _____
 _____ Hrs. Water Maint. Man - 2 at _____ \$ _____
 _____ Hrs. Garage Foreman _____ at _____ \$ _____
 _____ Hrs. Labor _____ at _____ \$ _____
 _____ Hrs. Compressor at _____ \$ _____
 _____ \$ _____
 _____ Trucking _____ \$ _____
 _____ Pav't Patch _____ \$ _____
 _____ \$ _____
 _____ \$ _____
 _____ \$ _____
 _____ \$ _____

TAX MAP 77

HUNTER St. Ave. No. 81

Name of Owner _____

Labor and Mat'l. Report 9/9/10

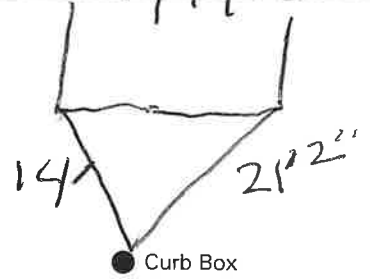

6" Main Elev. of Main at tap 4"

Gate at ● Gate at ●

