


LABOR AND MATERIALS


3/4	Copper Lead	Connection	_____	\$	_____
3/4	Curb	Cock Valve T.S. & V.	_____ in.	\$	_____
	Service box	Short 3-1/2 x 4-1/2	_____	\$	_____
	Old returned	Long 4-1/2 x 5-1/2	_____	\$	_____
19	Ft. 3/4" in.	Copper G.I. C.I.	Pipe at	\$	_____
	Nipples	_____ in.	at	\$	_____
	Bushings	_____ to _____ in.	at	\$	_____
	Red'g				
	Inc'g				
	Union	_____ in.	at	\$	_____
	Meter	_____ in.	at	\$	_____
	Compound Joints	at		\$	_____
	Maintenance Foreman			\$	_____
	Hrs. Water Maint. Man - 1	at		\$	_____
	Hrs. Water Maint. Man - 2	at		\$	_____
	Hrs. Garage Foreman	at		\$	_____
	Hrs. Labor	at		\$	_____
	Hrs. Compressor	at		\$	_____
	Trucking			\$	_____
	Pav't Patch			\$	_____
	Tony M			\$	_____
	WETP			\$	_____
	John D			\$	_____
	BILLS			\$	_____

St. ituntere
 Pl. Ave. No. 86
 Name of Owner _____

Labor and Mat'l. Report 10/27/06

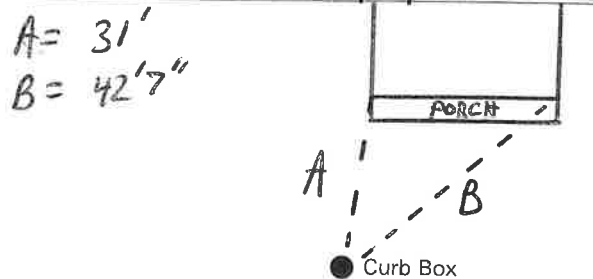

6" Main
 Elev. of Main at tap 4'

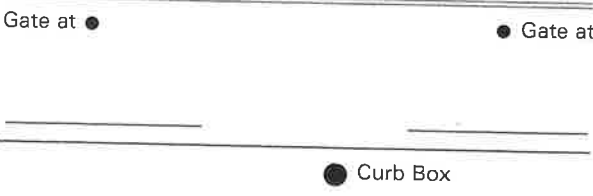

serve main 25' 6" off water curb box