


LABOR AND MATERIALS

1	Copper Lead	Connection	3/4"	\$
1	Curb	Cock Valve T.S. & V.	3/4 in.	\$
1	Service box	} Short 3 1/2 x 4 1/2 Long 4 1/2 x 5 1/2 Buff or Rdway		\$
	Old returned			\$
19	Ft. 3/4 in.	Copper } G.I. } G.I. }	Pipe at	\$
	Nipples	in.	at	\$
	Bushings	to	in. at	\$
	Red'g } Inc'g }	Coupl'gs	to in. at	\$
	Union	in.	at	\$
	Meter	in.	at	\$
	Lead Joints	at		\$
	Compound Joints	at		\$
	Maintenance Foreman			\$
	Hrs. Water Maint. Man-1	at		\$
	Hrs. Water Maint. Man-2	at		\$
	Hrs. Garage Foreman	at		\$
	Hrs. Labor	at		\$
	Hrs. Compressor	at		\$
	Compensation Ins.	at \$	per C	\$
	Trucking			\$
	Pay't Patch			\$
	Tap by Gifford & Co.			\$
	4-9-58			\$
	O'head			\$
				\$

St. Ph. Ave. No. 90
 Hunter

Name of Owner
 Emma Clark

Labor and Mat'l. Report Apr. 10 1958

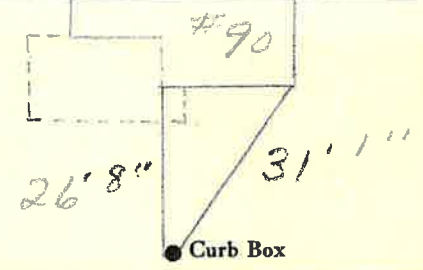

6" Main Elev. of Main at tap 3 1/2'

Gate at • Gate at
 19' to main

3/4" copper • Curb Box