


LABOR AND MATERIALS

1	Copper Lead	Connection	$\frac{3}{4}$ "	\$
1	Curb	Cock Valve T.S. & V.	$\frac{3}{4}$ in. <i>ori seal,</i>	\$
1	Service box Old returned	Short $3\frac{1}{2}$ x $4\frac{1}{2}$ Long $4\frac{1}{2}$ x $5\frac{1}{2}$ Buff or Rdway		\$
28	Ft.	$\frac{3}{4}$ in. { Copper G.I. C.I. }	Pipe at	\$
	Nipples	in. at		\$
	Bushings	to in. at		\$
	Red'g Inc'g	Coupl'gs to in. at		\$
	Union	in. at		\$
	Meter	in. at		\$
	Lead Joints	at		\$
	Compound Joints	at		\$
	Maintenance Foreman			\$
	Hrs. Water Maint. Man	1 at		\$
	Hrs. Water Maint. Man	2 at		\$
	Hrs. Garage Foreman	at		\$
	Hrs. Labor	at		\$
	Hrs. Compressor	at		\$
	Compensation Ins.	at \$ per C		\$
	Trucking			\$
	Pav't Patch			\$
	<i>Tap by Gifford & Co.</i>			\$
	<i>9-29-65.</i>			\$
	O'head			\$

Hunter St. *92*
-Pl. Ave. No.

Name of Owner
John Ross

Labor and Mat'l. Report *Sept. 29 1965.*

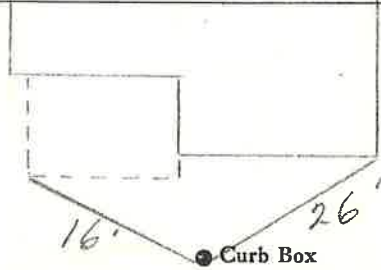

6" C.I. Tap on Sagamore St.
Main Elev. of Main at tap *3 1/2'*

Gate at • Gate at

• Curb Box
This Tap on "Sagamore St."