


LABOR AND MATERIALS

1 Copper } Connection  $\frac{3}{4}$ " \$  
 -Lead }  
 1 Curb } Cock Valve }  $\frac{3}{4}$  in. Oriseal \$  
 } T. S. & V. }  
 1 Service box } Short  $3\frac{1}{2}$  x  $4\frac{1}{2}$  }  
 -Old returned } Long  $4\frac{1}{2}$  x  $5\frac{1}{2}$  }  
 } Buff or Rdway } \$  
 26 Ft.  $\frac{3}{4}$  in. } Copper } Pipe at \$  
 } C.I. }  
 } C.I. }  
 Nipples in. at \$  
 Bushings to in. at \$  
 Red'g }  
 Inc'g } Coupl'gs to in. at \$  
 Union in. at \$  
 Meter in. at \$  
 Lead Joints at \$  
 Compound Joints at \$  
 Maintenance Foreman \$  
 Hrs. Water Maint. Man-1 at \$  
 Hrs. Water Maint. Man-2 at \$  
 Hrs. Garage Foreman at \$  
 Hrs. Labor at \$  
 Hrs. Compressor at \$  
 Compensation Ins. at \$ per C \$  
 Trucking \$  
 Pav't Patch \$  
 Tap by Larcourt Co. \$  
 9-25-69 \$  
 O'head \$

St.  
 Pt.  
 Ave. No. 95

Hunter  
 Name of Owner  
 A. M. Beadnell

Labor and Mat'l. Report Sept. 25 1969

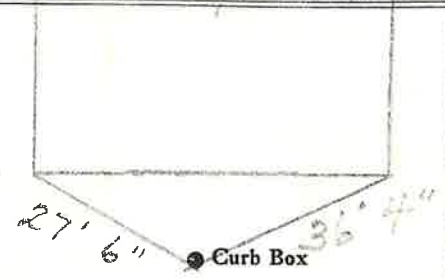

Hunter St.  
 6" Main Elev. of Main at tap 4'  
 Gate at • Gate at

• Curb Box