


LABOR AND MATERIALS

1	Copper	} Connection	3/4"	\$
	Lead			
1	Curb	} 3/4 in. Oriseal.	\$	
	Cock			
	Valve T.S. & V.			
1	Service box	} Short 3 1/2 x 4 1/2	\$	
	Old returned			Long 4 1/2 x 5 1/2
				Buff or Rdway
10	Ft. 3/4 in.	} Pipe at	\$	
				Copper
				G.I.
	Nipples	in. at	\$	
	Bushings	to in. at	\$	
	Red'g } Coupl'gs	to in. at	\$	
	Inc'g }			
	Union	in. at	\$	
	Meter	in. at	\$	
	Lead Joints	at	\$	
	Compound Joints	at	\$	
	Maintenance Foreman		\$	
	Hrs. Water Maint. Man-1	at	\$	
	Hrs. Water Maint. Man-2	at	\$	
	Hrs. Garage Foreman	at	\$	
	Hrs. Labor	at	\$	
	Hrs. Compressor	at	\$	
	Compensation Ins.	at \$ per C	\$	
	Trucking		\$	
	Pav't Patch		\$	
	Tap by Gifford & Co.		\$	
	9-30-65.		\$	
	O'head		\$	
			\$	

St. Hunter
 Pl. 97
 Ave. No. 97

Name of Owner Norman Pawcett.

Labor and Mat'l. Report Sept. 30 1965

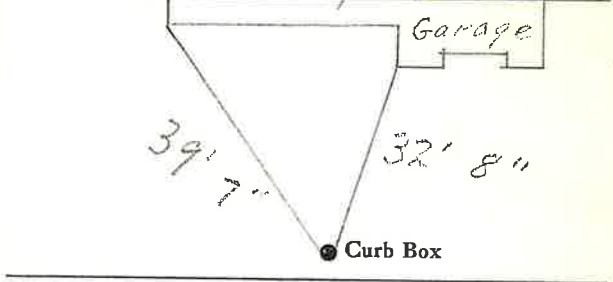

6" Ctl. Main Elev. of Main at tap 3 1/2'

Gate at • Gate at

• Curb Box