

LABOR AND MATERIALS

| | | | | | |
|----|-----------------------|--|-----------|---------|--|
| 1 | Copper Lead | Connection | 3/4" | \$ | |
| 1 | Curb | Cock Valve T.S. & V. | 3/4 in. | \$ | |
| 1 | Service box | { Short 3 1/2 x 4 1/2 } { Long 4 1/2 x 5 1/2 } { Buff or Rdway } | | \$ | |
| | Old returned | | | | |
| 10 | 3/4 in. | Copper | } Pipe at | \$ | |
| | | G.I. | | | |
| | Nipples | in. at | | \$ | |
| | Bushings | to in. at | | \$ | |
| | Red'g | | | \$ | |
| | Inc'g | Coupl'gs to in. at | | \$ | |
| | Union | in. at | | \$ | |
| | Meter | in. at | | \$ | |
| | Lead Joints | at | | \$ | |
| | Compound Joints | at | | \$ | |
| 5 | Maintenance Foreman | | | \$ | |
| | Hrs. Water Maint. Man | 1 at | | \$ | |
| | Hrs. Water Maint. Man | 2 at | | \$ | |
| | Hrs. Garage Foreman | at | | \$ | |
| 25 | Hrs. Labor | at | | \$ | |
| 2 | Hrs. Compressor | at | | \$ 3.00 | |
| | Compensation Ins. | at \$ per C | | \$ | |
| | Trucking | | | \$ | |
| | Pav't Patch | | | \$ | |
| | Tap made | 1925 | | \$ | |
| | | or 1926 | | \$ | |
| | O'head | | | \$ | |
| 11 | sticks Dynamite | | | \$.17 | |
| 7 | Electric Caps | | | .49 | |
| | Truck | | | 1.00 | |

Copy

Hunter


St. 99
 Pt. Ave. No. 91

Name of Owner

Reardon

Labor and Mat'l. Report

1925 or
 1926

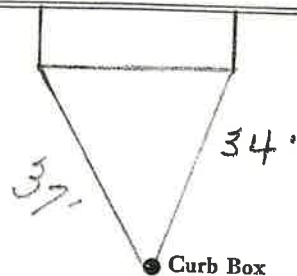

6" Main

Elev. of Main at tap 5'

Gate at ●

● Gate at

● Curb Box