


Labor and Materials

Copper } Connection.....	3	2.60
Lead } .....	2	
Curb { Cock } .....	3	2.27
{ Valve } .....	2	
{ T.S. & V. } .....	2	
Service Box { Short 3 1/2 x 4 1/2 } .....		1.38
Old returned { Irons 4 1/2 x 6 1/2 } .....		
{ Buff. or Redway } .....		
9 Ft. .... in. { Copper } Pipe at .....	3	1.67
{ Galv. Iron } .....		
{ Cast Iron } .....		
Nipples .....	in. at	\$
Bushings .....	to .....	in. at
Red'g } Couplings.....	to .....	in. at
Inc'g } .....		\$
Union.....	in. at	\$
Meter.....	in. at	\$
Lbs. Br. Stone at .....		\$
Lbs. Sand at .....		\$
Bags Cement at .....		\$
Paving Brick { Mack } at .....		\$
{ Red } .....		
{ Asphalt } .....		
Lead Joints at .....		\$
Leadite Joints at .....		\$
7 Hrs. Foreman at .....		1.25
10 Hrs. Common Labor at .....		4.50
Hrs. Common Labor at .....		\$
Hrs. Mason at .....		\$
Hrs. Masons Helper at .....		\$
Hrs. Compressor at .....		\$
Compensation Ins .....		1.8
Trucking .....		1.00
Builders Use of Water Patch .....		5.00
Total \$		19.80

532-7 101  
 Labor and Material Report July 9 1932

99 Hunter St

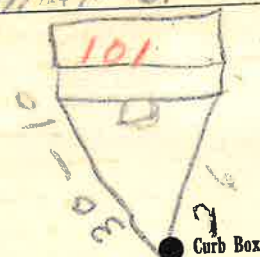

6 Main Elev. of Main at tap 4 1/2  
 Gate at ● Gate at ●

● Curb Box

New House  
 Tap made in Jan 1932

LTD.