


**Labor and Materials**

.. 4 ..	Copper } Connection.....	\$ 1.48
.. 1 ..	Lead } .....	.....
.. 1 ..	Curb { Cock } .....	\$ 1.79
.. 1 ..	{ Valve } .....	.....
.. 1 ..	{ T.S.&V. } .....	.....
.. 1 ..	Service Box { Short 3 1/2 x 4 1/2 } .....	\$ 1.30
.. 1 ..	Old returned { Long 4 1/2 x 5 1/2 } .....	.....
.. 19 ..	{ Buff. or Rdway } .....	.....
.. 19 ..	Ft. .... in. { Copper } Pipe at .....	\$ 2.42
.. 1 ..	{ Galv. Iron } .....	.....
.. 1 ..	{ Cast Iron } .....	.....
.. 1 ..	Nipples ..... in. at .....	\$ .....
.. 1 ..	Bushings .. 1/2 .. to .. 3/4 .. in. at .....	\$ .....
.. 1 ..	Red'g } Couplings..... to .. in. at .....	\$ .....
.. 1 ..	Inc'g } .....	.....
.....	Union..... in. at .....	\$ .....
.....	Meter..... in. at .....	\$ .....
.....	Lbs. Br. Stone at .....	\$ .....
.....	Lbs. Sand at .....	\$ .....
.....	Bags Cement at .....	\$ .....
.....	Paving Brick { Mack } at .....	\$ .....
.....	{ Red } .....	.....
.....	{ Asphalt } .....	.....
.....	Lead Joints at .....	\$ .....
.....	Leadite Joints at .....	\$ .....
.. 5 ..	Hrs. Foreman at .....	\$ 3.13
.. 17 ..	Hrs. Common Labor at .....	\$ 5.40
.....	Hrs. Common Labor at .....	\$ .....
.....	Hrs. Mason at .....	\$ .....
.....	Hrs. Masons Helper at .....	\$ .....
.....	Hrs. Compressor at .....	\$ .....
.....	Compensation Ins .....	\$ 76
.....	Trucking .....	\$ 1.-
.....	Builders Use of Water <i>Patel</i> .....	\$ 5.-
Total		\$ 22.89

6 Hunter St

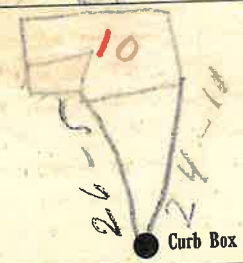

9 Main Elev. of Main at tap 5

Gate at ● Gate at ●

● Curb Box

*old tap shut off*

*Call 4111*