


Labor and Materials

1	Copper	Connection	3	\$ 3.20
1	Curb	Cock Valve T.S. & V.	3/4	\$ 10.00
1	Service Box	Short 3 1/2 x 4 1/2		\$ 1.30
	Old removed	Build. or Railway		
24	Ft.	Copper Pipe at		\$ 5.25
	Nipples	in. at		\$
	Bushings	to in. at		\$
	Red'g Inc'g	Couplings to in. at		\$
	Union	in. at		\$
	Meter	in. at		\$
	Lbs. Br. Stone	at		\$
	Lbs. Sand	at		\$
	Bags Cement	at		\$
	Paving Brick	Mack Red Asphalt at		\$
	Lead Joints	at		\$
	Leadite Joints	at		\$
3	Hrs. Foreman	at	1.25	\$ 1.88
17	Hrs. Common Labor	at	2.88	\$ 4.88
	Hrs. Common Labor	at		\$
	Hrs. Mason	at		\$
	Hrs. Mason's Helper	at		\$
	Hrs. Compressor	at		\$
	Compensation Ins.		1.8	\$ 1.8
	Trucking		100	\$ 100
	Builders' Use of Water			\$
Total				\$ 18.72

27-184 102 HUNTER ST
 Labor and Material Report Oct 14 19 27

86 Hunter St

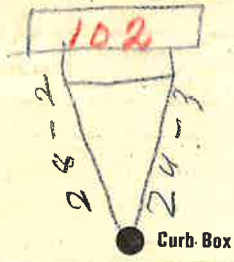

6 Main Elev. of Main at tap 4 1/2

Gate at 24' to main Gate at

3/4" COPPER Curb Box