

Labor and Materials

Copper } Connection.....	3	\$ 3.20
Lead } Connection.....		
Curb { Cock } Valve } T. S. & V. } in.....	4	\$ 1.50
Service Box { Short 3 1/2 x 4 1/2 } Old returned { Long 4 1/2 x 5 1/2 } { Buff. or Rdway }		\$ 1.20
2 1/4 Ft. in. { Copper } Galv. Iron } Cast Iron } Pipe at.....	2	\$ 5.28
Nipples..... in. at.....		\$
Bushings..... to..... in. at.....		\$
Red'g } Inc'g } Couplings..... to..... in. at.....		\$
Union..... in. at.....		\$
Meter..... in. at.....		\$
Lbs. Br. Stone at.....		\$
Lbs. Sand at.....		\$
Bags Cement at.....		\$
Paving Brick { Mack } Red } Asphalt } at.....		\$
Lead Joints at.....		\$
Leadite Joints at.....		\$
2 Hrs. Foreman at.....	6 2/2	\$ 1.25
11 Hrs. Common Labor at.....	40 5/8	\$ 4.47
Hrs. Common Labor at.....		\$
Hrs. Mason at.....		\$
Hrs. Mason's Helper at.....		\$
Hrs. Compressor at.....		\$
Compensation Ins.....		\$ 1.10
Trucking.....		\$ 1.00
Builders' Use of Water.....		\$
Total \$.		17.65


28-64

104

Labor and Material Report

19

88 H. H. H. H.

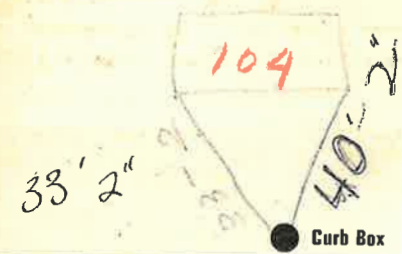

TAX ID # 303.13-3-20

Main Elev. of Main at tap

Gate at ● 24' to MAIN ● Gate at

Copper ● Curb Box

New House