

LABOR AND MATERIALS

?	Copper	}	Connection		\$	
	Lead					
	Curb	{	Clock Valve T. S. & V.	} in.	\$	
	Service box	{	Short 3 1/2 X 4 1/2	}		
	Old returned	{	Long 4 1/2 X 5 1/2	}	\$	
			Buff or Rdway			
?	Ft.	in. ?	{	Copper Galv. Iron Cast Iron	} Pipe at	\$
	Nipples	in. at			\$	
	Bushings	to	in. at		\$	
	Red'g Inc'g	} Couplings	to	in. at	\$	
	Union	in. at			\$	
	Meter	in. at			\$	
	Lead Joints	at			\$	
	Compound Joints	at			\$	
	Hrs. Foreman	at			\$	
	Hrs. Chauffeur	at			\$	
	Hrs. Tapper	at			\$	
	Hrs. Labor	at			\$	
	Hrs. Labor	at			\$	
	Hrs. Compressor	at			\$	
	Compensation Ins.				\$	
	Trucking				\$	
	Builders Use of Water				\$	
	<i>Measured by [Signature]</i>				\$	
					\$	
					\$	
					\$	
					\$	

117
 St. _____
 Pl. _____
 Ave. No. 119

Hunter

Name of Owner _____

Remeasured Apr. 22-71.

Labor and Mat'l. Report Dec 3 19 45

117
119


See
Below

? 27'5" 24'0" ?


Main
Elev. of Main at tap

Gate at ●
● Gate at

LSM-5C-6-1-45

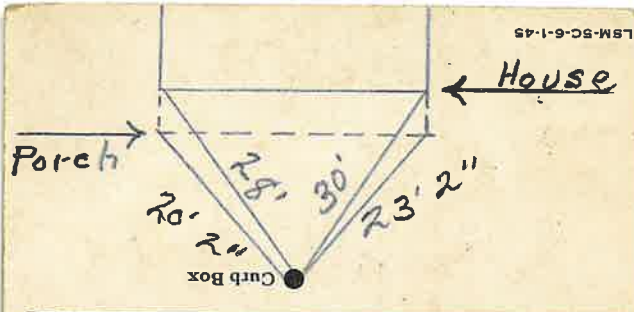

Gate at ● Gate at ●
 Elev. of Main at tap

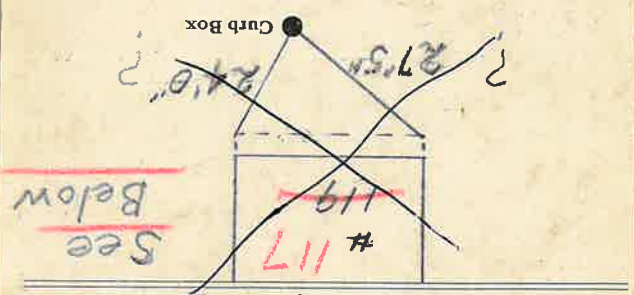

Name of Owner
 Hunter
 St. Pl. No. 119
 # 117

Measured Apr. 22-71.
 Labor and Mat'l. Report - Dec 3 19 05