

### Labor and Materials

1	Copper	Connection	3	\$ 1.43
1	Curb	Cock Valve F. S. & V.	3	\$ 1.88
1	Service Box Old returned	Short 3 1/2 x 4 1/2 Long 4 1/2 x 5 1/2 Buff. or Rdway		\$ 1.75
28 Ft.	3/4 in.	Copper Gate Iron Cast Iron	Pipe at 1.89	\$ 5.04
	Nipples	in. at		\$
	Bushings	to in. at		\$
	Red'g Inc'g	Conplings to in. at		\$
	Union	in. at		\$
	Meter	in. at		\$
	Lead Joints	at		\$
	Leadite Joints	at		\$
	Hrs. Foreman	at		\$
2	Hrs. Chauffeur	at 6 1/2		\$ 1.25
4	Hrs. Tapper	at 2		\$ 2.50
8	Hrs. Labor	at 45		\$ 3.60
	Hrs. Labor	at		\$
	Hrs. Compressor	at		\$
	Compensation Ins.			\$ 23
	Trucking			\$ 1.00
	Builders Use of Water			\$
	Tap to Ream			\$
	1 1/2 Patch (sewer also)			\$ 2.50
				\$
				\$
				\$ 21.19

1 6 1938


St. 118  
Pt.  
Ave. No. 102

Hunter

Name of Owner

Malone

Labor and Mat'l. Report 4-28-38 19

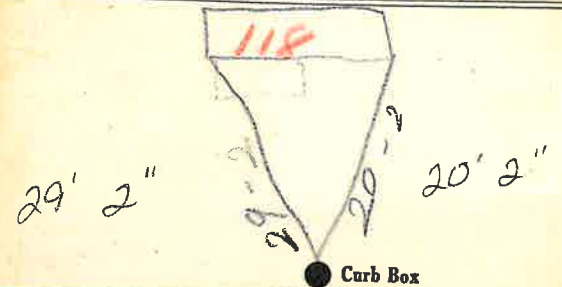

6" Main

Elev. of Main at tap 5

Gate at ●

● Gate at

● Curb Box

New house.

118