


### Labor and Materials

Copper } Connection.....	3	\$ 2.70
Lead } Cock		
Curb } Valve	3	\$ 2.34
	T.S. & V.	
Service Box } Short 3/4 x 1 1/2		
Old returned } Long 4 1/2 x 5 1/2		\$ 1.55
	Buff or Rdway	
11 Ft. .... in. } Copper	3	\$ 2.70
	Galv. Iron	
	Cast Iron	
Nipples..... in. at.....	4	\$
Bushings..... to..... in. at.....		\$
Red'g } Couplings..... to..... in. at.....		\$
Inc'g }		\$
Union..... in. at.....		\$
Meter..... in. at.....		\$
Lbs. Br. Stone at.....		\$
Lbs. Sand at.....		\$
Bags Cement 'at.....		\$
Paving Brick } Mack		\$
	Red	
	Asphalt	
Lead Joints at.....		\$
Leadite Joints at.....		\$
2 Hrs. Foreman at.....		\$ 1.25
11 Hrs. Common Labor at.....		\$ 4.95
Hrs. Common Labor at.....		\$
Hrs. Mason at.....		\$
Hrs. Mason's Helper at.....		\$
Hrs. Compressor at.....		\$
Compensation Ins.....		\$ 1.19
Trucking.....		\$ 1.11
Builders' Use of Water Patch.....		\$ 5.00
<b>Total \$</b>		<b>21.73</b>

### Labor and Material Report

Aug 23 1930

105 Hunter + B... Ave

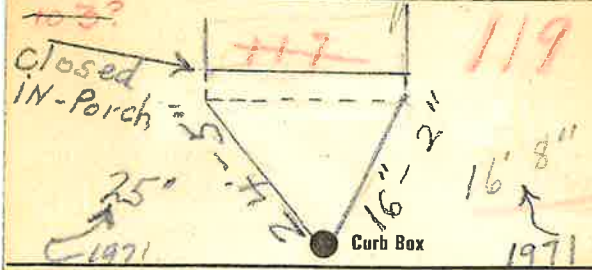

Main Elev of Main at tap 4.5  
Gate at ● Gate at ●

● Curb Box

*new sand cover of  
punter of curb box  
and*