

**Labor and Materials**

Copper	Lead	Connection	2	\$ 2.60
Curb	Cock Valve	in	2	\$ 2.30
Service Box	Short 3 1/2 x 4 1/2	}	7	\$ 1.40
Old returned	Long 1 1/2 x 5 1/2			
15 Ft.	Copper Galv. Iron	Pipe at	3	\$ 3.98
Nipples	in.	at	4	\$
Bushings	to	in.	at	\$
Red'g Inc'g	Couplings	to	in.	at
Union	in.	at		\$
Meter	in.	at		\$
Lbs. Br. Stone	at			\$
Lbs. Sand	at			\$
Bags Cement	at			\$
Paving Brick	Mack Red Asphalt	at		\$
Lead Joints	at			\$
Leadite Joints	at			\$
3 Hrs.	Foreman	at		\$ 1.88
16 Hrs.	Common Labor	@ .45		\$ 7.20
Hrs.	Common Labor	at		\$
Hrs.	Mason	at		\$
Hrs.	Mason's Helper	at		\$
Hrs.	Compressor	at		\$
Compensation	Ins		28	\$
Trucking			1	\$ -
Builders' Use of Water	Patch			\$ 5. -
Total \$				25.64


30-7

11 A-B

3-21-1930

**Labor and Material Report**

7-9 Hunter St

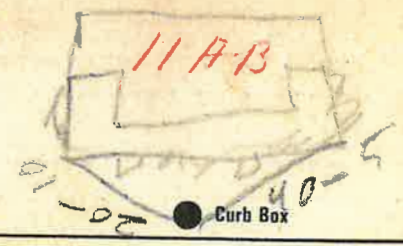

4 Main

Elev of Main at tap

Gate at

Gate at

TAX ID # 302.16-15-18

Curb Box

Old tap disconnected