

Labor and Materials

Copper	} Connection	3/4	\$ 320	
Lead				
Curb	} Cock			
	} Valve	3/4 in.	\$ 100	
	T. S. & V.			
Service Box	} Short 31 x 41		\$ 140	
Old returned	} Long 41 x 51			
	} Buff. or Rdway			
26 Ft. 3/4 in.	} Copper	} Pipe at	\$ 5.50	
	} Galv. Iron			
	} Cast Iron			
Nipples	in. at		\$	
Bushings	to	in. at	\$	
1 Red'g	} Couplings	2 1/2 to	\$ 1.50	
1 In. or				
Union	in. at		\$	
Meter	in. at		\$	
Lbs. Br. Stone	at		\$	
Lbs. Sand	at		\$	
Bags Cement	at		\$	
Paving Brick	} at	Mack	\$	
				Red
				Asphalt
Lead Joints	at		\$	
Leadite Joints	at		\$	
4 Hrs. Foreman	at		\$ 2.50	
16 Hrs. Common Labor	at		\$ 6.50	
Hrs. Common Labor	at		\$	
Hrs. Mason	at		\$	
Hrs. Mason's Helper	at		\$	
Hrs. Compressor	at		\$	
Compensation Ins.			\$.24	
1 Trucking			\$ 1.00	
Builders' Use of Water			\$	
Total			\$ 21.49	


27-62

122

Labor and Material Report July 7

1921

no 108 East Hunter St

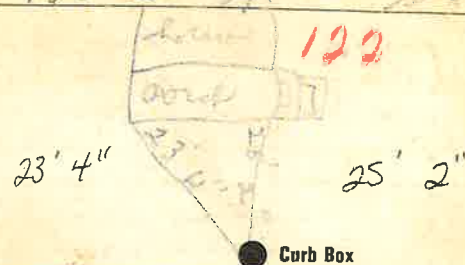

6" Main

Elev. of Main at tap

Gate at ●

● Gate at

● Curb Box

new house
see top