

Labor and Materials

1	Copper	} Connection. ^{3/4}	\$. 1.25
1	Lead			
1	Curb	} Cock Valve T.S.&V. ^{3/4} in	\$. 1.70
1	Service Box			
	Old returned	{ Short 3 1/2 x 4 1/2 Long 4 1/2 x 5 1/2 Buff. or Rdway	\$. 1.45
9	Ft. ^{3/4}	} Copper Galv. Iron Cast Iron	Pipe at ^{13 1/2}	\$. 1.08
	in			
	Nipples in. at	\$.
	Bushings to	in. at \$.
	Red'g Inc'g	} Couplings to	in. at
	Union in. at	\$.
	Meter in. at	\$.
	Lbs. Br. Stone	at	\$.
	Lbs. Sand	at	\$.
	Bags Cement	at	\$.
	Paving Brick	{ Mack Red Asphalt	} at \$.
	Lead Joints			
	Leadite Joints	at	\$.
A	Hrs. Foreman	at	^{6 2/3} \$ 2.50
	Hrs. Common Labor	at	\$.
	Hrs. Common Labor	at	\$.
	Hrs. Mason	at	\$.
	Hrs. Masons Helper	at	\$.
	Hrs. Compressor	at	\$.
	Compensation Ins		\$. 09
	Trucking		\$. 67
	Builders Use of Water	Patch	\$. 2.50


Total \$ 11.57

1935-107

Labor and Material Report

Sept 6 1935

36' tap at 7 1/2" Hunter at

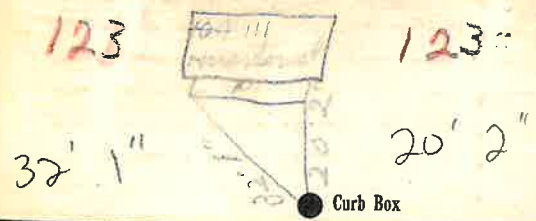

6" Main Elev. of Main at tap

Gate at Gate at

Curb Box

See House


[Handwritten signature]

Labor and Materials

Copper } Connection	?	\$ 2.70
Lead } Connection	2	
Curb } Cock Valve	1	\$ 2.39
} T. S. & V.		
Service Box } Short 3 1/2 x 4 1/2	1	\$ 1.45
Old returned } Long 4 x 5 1/2		
} Buff. or Rdway		
Pt. in. } Copper	2	\$ 2.16
} Galv. Iron		
} Cast Iron		
Nipples	in. at	\$
Bushings	to	in. at
Red'g } Couplings	to	in. at
Inc'g }		
Union	in. at	\$
Meter	in. at	\$
Lbs. Br. Stone at		\$
Lbs. Sand at		\$
Bags Cement at		\$
Paving Brick } Mack	} at	\$
} Red		
} Asphalt		
Lead Joints at		\$
Leadite Joints at		\$
2 Hrs. Foreman at		\$ 1.25
6 Hrs. Common Labor at		\$ 2.70
Hrs. Common Labor at		\$
Hrs Mason at		\$
Hrs Mason's Helper at		\$
Hrs. Compressor at		\$
Compensation Ins		\$.12
Trucking		\$ 1.00
Builders' Use of Water	Patch	\$ 5.00
Total \$		18.77

~~111~~ *Hammer St*

123

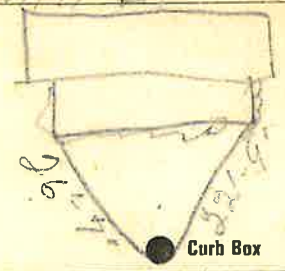

6 Main Eley of Main at tap *4 1/2*

Gate at ● Gate at ●

● Curb Box

New House

119 Robert Hall

(131)

1.160-29046