


Labor and Materials

Copper	} Connection.....	3/4	\$ 1.48	
Lead				
Curb	} Cock Valve T.S.&V. }	in	\$ 1.79	
Service Box				
Old returned	} Short 3 1/2 x 4 1/2 }	in	\$ 1.30	
2 1/2 Ft.	} Copper Galv. Iron } Pipe at	in	\$ 4.50	
Nipples	in. at	\$	
Bushings	to	in. at	\$
Red'g Inc'g	} Couplings,.....	to	in. at	\$
Union				
Meter	in. at	\$	
Lbs. Br. Stone	at	\$		
Lbs. Sand	at	\$		
Bags Cement	at	\$		
Paving Brick	} Mack Red Asphalt } at	\$		
Lead Joints		at	\$	
Leadite Joints	at	\$		
2 Hrs. Foreman	at	\$ 1.25		
Hrs. Common Labor	at	\$		
4 Hrs. Common Labor	at	\$ 1.80		
Hrs. Mason	at	\$		
Hrs. Masons Helper	at	\$		
Hrs. Compressor	at	\$		
Compensation Ins	\$.10		
Trucking	\$ 1.00		
Builders Use of Water	Patch -	\$ 2.50		
Total			\$ 15.77	

32-72 1290-129
 Labor and Material Report June 23 1912

110 Hunter St

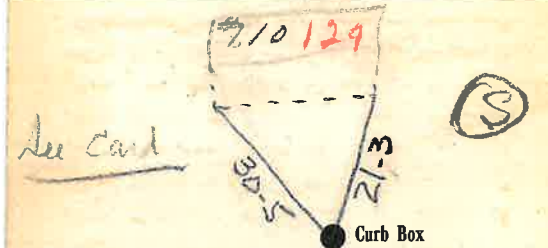

6 Main Elev. of Main at tap 5
 Gate at • Gate at •

• Curb Box

OK 9/10

Labor and Materials

1	Copper } Connection.....	3	\$ 3 20
	Lead }		
1	Curb } Cock }	2	\$ 1 00
	Valve }	4	
	T. S. & V. }		
1	Service Box } Short 3 1/2 x 4 1/2 }		\$ 1 30
	Old returned } Long 1 1/2 x 3 1/2 }		
		Buff. or Rdway }	
26	Ft. in. } Copper } Pipe at.....	3	\$ 5 72
		Cast Iron }	
	Nipples..... in. at.....		\$
	Bushings..... to..... in. at.....		\$
	Red'g } Couplings..... to..... in. at.....		\$
	Inc'g }		\$
	Union..... in. at.....		\$
	Meter..... in. at.....		\$
	Lbs. Br. Stone at.....		\$
	Lbs. Sand at.....		\$
	Bags Cement at.....		\$
	Paving Brick } Mack } at.....		\$
		Red }	
		Asphalt }	
	Lead Joints at.....		\$
	Leadite Joints at.....		\$
	Hrs. Foreman at.....		\$
2	Hrs. Common Labor at.....	6 2 1/2	\$ 12 50
2	Hrs. Common Labor at.....	5 0	\$ 10 00
	Hrs. Mason at.....		\$
	Hrs. Mason's Helper at.....		\$
	Hrs. Compressor at.....		\$
	Compensation Ins.....		\$ 10 60
	Trucking		\$ 1 00
	Builders' Use of Water.....		\$
Total \$			14 53


27-144

124 or 122

Labor and Material Report

Sept. 19 1927

119 Huntrest (Huntley)

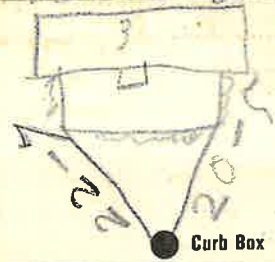

6 Main

Elev. of Main at tap 5

Gate at ●

● Gate at

● Curb Box

New Honor