

### Labor and Materials

1	Copper } Connection.....	\$ 3.20
	Lead } .....	
1	Curb } Cock } .....	\$ 1.00
	Valve } T. S. & V. } .....	
1	Service Box } Short 3 1/2 x 1 1/2 } .....	\$ 1.30
	Old returned } Long 4 x 2 1/2 } .....	
	Buff. on Rdway } .....	
2	Ft. } in. } Copper } Pipe at.....	\$ 5.72
		Galv. Iron }
		Cast Iron }
	Nipples..... in. at.....	\$
	Bushings..... to..... in. at.....	\$
	Red'g } Couplings..... to..... in. at.....	\$
	Inc'g } .....	
	Union..... in. at.....	\$
	Meter..... in. at.....	\$
	Lbs. Br. Stone at.....	\$
	Lbs. Sand at.....	\$
	Bags Cement at.....	\$
	Paving Brick } Mack } at.....	\$
	Red } .....	
	Asphalt } .....	
	Lead Joints at.....	\$
	Leadite Joints at.....	\$
2	Hrs. Foreman at.....	\$ 1.25
3	Hrs. Common Labor at.....	\$ 2.22
	Hrs. Common Labor at.....	\$
	Hrs. Mason at.....	\$
	Hrs. Mason's Helper at.....	\$
	Hrs. Compressor at.....	\$
	Compensation Ins.....	\$ 0.7
	Trucking.....	\$ 1.00
	Builders' Use of Water.....	\$
Total \$		14.76


28-175

126

Labor and Material Report

Dec 10 1928

112 Hunter St.

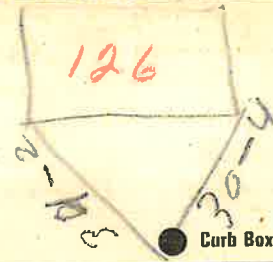

See below.

6" Main

Elev of Main at tap 5 1/2

Gate at ●

● Gate at

Curb Box

30'

25' 9"

Remeasured  
1-22-68

Closed in

House