

### LABOR AND MATERIALS

1	Copper Lead	} Connection	3/4		\$	
1	Curb	{ Clock Valve T. S. & V. }	1	in.	\$	
1	Service box Old returned	{ Short 3 1/4 X 4 1/4 Long 4 1/4 X 5 1/4 Buff or Rdway }			\$	
8	Ft.	1	in.	{ Copper Galv. Iron Cast Iron }	Pipe at \$	
	Nipples		in.	at	\$	
	Bushings		to	in.	at \$	
	Red'g Inc'g	{ Couplings		to	in.	at \$
	Union		in.	at	\$	
	Meter		in.	at	\$	
	Lead Joints				\$	
	Compound Joints				\$	
	Hrs. Foreman				\$	
	Hrs. Chauffeur				\$	
	Hrs. Tapper				\$	
	Hrs. Labor				\$	
	Hrs. Labor				\$	
	Hrs. Compressor				\$	
	Compensation Ins.				\$	
	Trucking				\$	
	Builders Use of Water				\$	
	<i>Measure by Maguire</i>				\$	
					\$	
					\$	
					\$	


St. 127  
Pl.  
Ave. No. 115

Hunter St

Name of Owner

measured in

Labor and Mat'l Report Dec 3 19 41

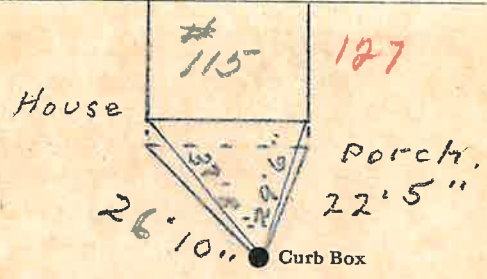

Main Elev. of  
Main at tap

Gate at ● ● Gate at

- Curb Box
- A - Porch Left 26' 10"
- B - " Right 22' 5"
- C - House Left 37' 8"
- D - " Right 29' 6"