


Labor and Materials

1	Copper	Lead	Connection	3/4"	\$ 3.20
1	Curb	Cock Valve T. S. & V.	3/4" in.	\$ 1.00	
1	Service Box	Old returned	Short 3/4"x4 1/2" Long 4 1/2"x5 1/2" Buff. or Rdway	\$ 1.30	
35	Ft.	3/4" in.	Copper Galv. Iron	Pipe at	\$ 5.50
1	Nipples	3/4" in.	at	\$.12	
	Bushings	to	in. at	\$	
1	Red'g Inc'g	Couplings	1" to 3/4" in.	at	\$.18
	Union	in.	at	\$	
	Meter	in.	at	\$	
	Lbs. Br. Stone	at	\$		
	Lbs. Sand	at	\$		
	Bags Cement	at	\$		
	Paving Brick	Mack Red Asphalt	at	\$	
	Lead Joints	at	\$		
	Leadite Joints	at	\$		
10	Hrs.	Foreman	at	\$ 6.25	
8	Hrs.	Common Labor	at	\$ 3.25	
	Hrs.	Common Labor	at	\$	
	Hrs.	Mason	at	\$	
	Hrs.	Mason's Helper	at	\$	
	Hrs.	Compressor	at	\$	
	Compensation	Ins.	\$ 2.25		
	Trucking	\$ 1.00			
	Builders' Use of Water	\$			
Total					\$ 22.05

114 East Hunter St.

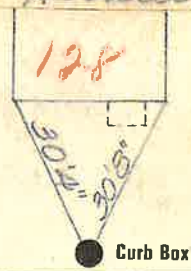

6" Main Elev of Main at tap *4.61*

Gate at ● ● Gate at

● Curb Box