

LABOR AND MATERIALS

1	Copper	Lead	Connection	3/4"	\$	2.41
1	Curb	Cock Valve	T. S. & V.	3/4 in.	\$	3.41
1	Service box	Old returned	Short 3 1/2 X 4 1/2 Long 4 1/2 X 5 1/2 Buff or Rdway		\$	4.18
9	3/4 in.	Copper	G. I.	Pipe at 110	\$	3.60
	Nipples			in. at	\$	
	Bushings			to in. at	\$	
	Inc'g	Coupl'gs		to in. at	\$	
	Union			in. at	\$	
	Meter			in. at	\$	
	Lead Joints				\$	
	Compound Joints				\$	
	Hrs. Water Maint. Man-1			at	\$	
6	Hrs. Water Maint. Man-2			at 1.24	\$	7.44
7	Hrs. Labor			at 1.13	\$	7.91
	Hrs. Labor			at	\$	
	Hrs. Compressor			at	\$	
	Compensation Ins.			at \$ 3.84 per C	\$	5.9
	Trucking				\$	1.50
	Pav't Patch				\$	14.40
	Tap made 4-28-54				\$	
	By Gifford & Wadleigh				\$	
	O'head				\$	
					\$	45.44

31.04

22-54


St.
Pl.
Ave. No. 131

Hunter

Name of Owner

Helm

Labor and Mat'l. Report April 28 1954

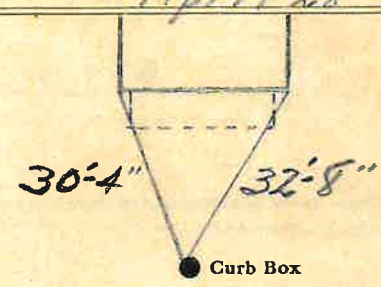

6" Main Elev. of Main at tap 5'
Gate at ● Gate at ●

● Curb Box
This Tap was made to remove other Tap that was under tree. old Tap is disconnected at Mains 4-29-54 by Gifford & Wadleigh