

### LABOR AND MATERIALS

1	Copper	{ Connection	3/4		\$ 2.29
1	Curb	{ Cock Valve T.S. & V.	3/4 in.		\$ 2.70
1	Service box Old returned	{ Short 3 1/2 x 4 1/2 Long 4 1/2 x 5 1/2 Buff or Rdway		\$ 4.25	
27	Ft. 3/4 in.	{ Copper G.I. C.I.	} Pipe at 35		\$ 9.45
	Nipples	in. at			\$
	Bushings	to in. at			\$
	Red'g Inc'g	{ Coupl'gs to in. at			\$
	Union	in. at			\$
	Meter	in. at			\$
	Lead Joints at				\$
	Compound Joints at				\$
	Hrs. Water Maint. Man-1 at				\$
5	Hrs. Water Maint. Man-2 at	1.02			\$ 5.10
12	Hrs. Labor at	91			\$ 10.92
	Hrs. Labor at				\$
	Hrs. Compressor at				\$
	Compensation Ins. at \$	per C.		36	\$
	Trucking				\$ 16.88
	Pav't Patch				\$
	<i>Trip by Magnum</i>				\$
	O'head				\$
					\$ 52.95

16-1950


St.  
Pt.  
Ave. No. 132

Hunter

Name of Owner

O'Connor

Labor and Mat'l. Report April 4 1950

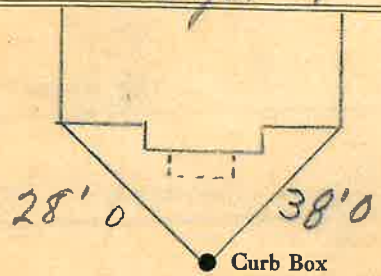

6

Main

Elev. of  
Main at tap 4 1/2

Gate at ●

● Gate at

● Curb Box