


LABOR AND MATERIALS

| | | | | |
|----|-----------------------|---------------------|---------|----|
| 1 | Copper Lead | Connection | 3/4" | \$ |
| 1 | Curb | Clock Valve | 3/4 in. | \$ |
| 1 | Service box | Short 3 1/2 X 4 1/2 | | \$ |
| | Old returned | Long 4 1/2 X 5 1/2 | | \$ |
| | | Buff or Rdway | | \$ |
| 10 | Ft. | 3/4 in. Copper Pipe | | \$ |
| | | Galv. Iron | | \$ |
| | | Cast Iron | | \$ |
| | Nipples | in. at | | \$ |
| | Bushings | to in. at | | \$ |
| | Red'g Inc'g | Couplings to in. at | | \$ |
| | Union | in. at | | \$ |
| | Meter | in. at | | \$ |
| | Lead Joints | at | | \$ |
| | Compound Joints | at | | \$ |
| 2 | Hrs. Foreman | at | | \$ |
| | Hrs. Chauffeur | at | | \$ |
| | Hrs. Tapper | at | | \$ |
| 3 | Hrs. Labor | at | 1.50 | \$ |
| | Hrs. Labor | at | | \$ |
| | Hrs. Compressor | at | | \$ |
| | Compensation Ins. | | | \$ |
| | Trucking | | | \$ |
| | Builders Use of Water | | | \$ |
| | | | | \$ |
| | | | | \$ |
St. 135
 #
 Ave. No. 121
 Hunter

Name of Owner
 TAX ID # 303.13-12-5

Labor and Mat'l. Report Nov 16 19 27

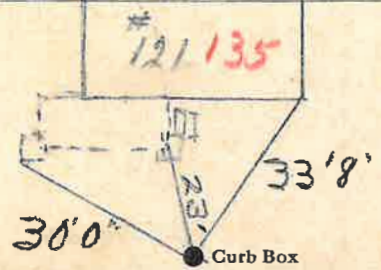

6" Main Elev. of Main at tap 4 1/2'
 Gate at ● Gate at ●

● Curb Box