

LABOR AND MATERIALS

1 Copper Lead	Connection	3/4	\$ 1.35
1 Curb	Cock Valve T. S. & V.	3/4 in.	\$ 1.98
1 Service Box Old - returned	Short 3 1/2 x 4 1/2 Long 4 1/2 x 5 1/2 Buff. or Rdway		\$ 1.82
9 Ft. 3/4 in.	Copper Galv Iron Cast Iron	Pipe at 20	\$ 1.80
Nipples	in. at		\$
Bushings	to in. at		\$
Red'g Inc'g	Couplings	to in. at	\$
Union	in. at		\$
Meter	in. at		\$
Lead Joints	at		\$
Leadite Joints	at		\$
Hrs. Foreman	at		\$
2 1/2 Hrs. Chauffeur	at	6834	\$ 1.73
1 1/2 Hrs. Tapper	at		\$ 1.04
2 1/2 Hrs. Labor	at	55	\$ 1.38
Hrs. Labor	at		\$
Hrs. Compressor	at		\$
Compensation Ins.			\$.13
Trucking			\$ 1-
Builders Use of Water			\$
WATERMETER			\$
			\$
			\$
			\$
			\$ 12.13

H.

16 1942

St. 137
Pl. -
Ave. No. 123

Hunter


Name of Owner

Griffith

Labor and Mat'l. Report

May 5

1942

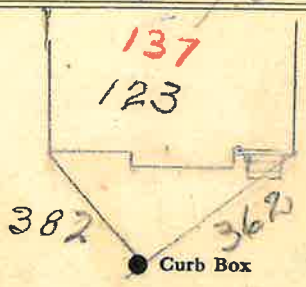

6 Main

Elev. of Main at tap 5

Gate at ●

● Gate at

● Curb Box