

LABOR AND MATERIALS

1	Copper	Connection	3/4"	\$	2.76
	Lead				
1	Curb	Cock Valve	3/4 in.	\$	3.49
		T. S. & V.			
1	Service box	Short 3/2 X 4 1/2		\$	4.74
	Old returned	Long 4 1/2 X 5 1/2			
		Buf or Rdway			
10	Ft.	Copper	3/4 in.	Pipe at 38	\$ 3.80
		G. I.			
		C. I.			
	Nipples	in. at		\$	
	Bushings	to in. at		\$	
	Red'g				
	Inc'g	Coupl'gs to in. at		\$	
	Union	in. at		\$	
	Meter	in. at		\$	
	Lead Joints	at		\$	
	Compound Joints	at		\$	
	Hrs. Water Maint. Man	—1 at		\$	
2	Hrs. Water Maint. Man	—2 at	1.24	\$	2.48
4	Hrs. Labor	— at	1.13	\$	4.52
	Hrs. Labor	— at		\$	
	Hrs. Compressor	at		\$	
	Compensation Ins.	at \$4.00 per C		\$	31
	Trucking			\$	1.00
	Pay't Patch			\$	12.00
Tap by Griff 014/12-10-52					
	O'head			\$	
					\$ 35.70


2310

453

St. HUNTER
~~Pt.~~
 Ave. No. 143

Name of Owner
Griffin

Labor and Mat'l. Report Dec. 10 1952

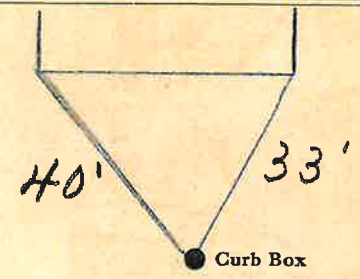

6" Main Elev. of Main at tap 3 1/2"
 Gate at ● ● Gate at

● Curb Box