

LABOR AND MATERIALS


1	Copper Lead	} Connection 1" _____ \$
1	Curb	
1	Service box Old returned	} Short 3 1/2 x 4 1/2 Long 4 1/2 x 5 1/2 Buffer Redway } _____ \$
23	Ft. 1 in.	
	Nipples	in. at _____ \$
	Bushings	to _____ in. at _____ \$
	Red'g Inc'g	} Coupl'gs. to _____ in. at _____ \$
	Union	
	Meter	in. at _____ \$
	Lead Joints	at _____ \$
	Compound Joints	at _____ \$
	Maintenance Foreman	_____ \$
	Hrs. Water Maint. Man-1	at _____ \$
	Hrs. Water Maint. Man-2	at _____ \$
	Hrs. Garage Foreman	at _____ \$
	Hrs. Labor	at _____ \$
	Hrs. Compressor	at _____ \$
	Compensation Ins. at \$	per C _____ \$
	Trucking	_____ \$
	Pav't Patch	_____ \$
	Tap made By Beecher	\$ 6 _____ \$
	O'head	April-1974 _____ \$

23
23

IDA St. Pl. Ave. No. 3-5

Name of Owner
MURRAY CEMENT BLOCK

Labor and Mat'l. Report April 1974

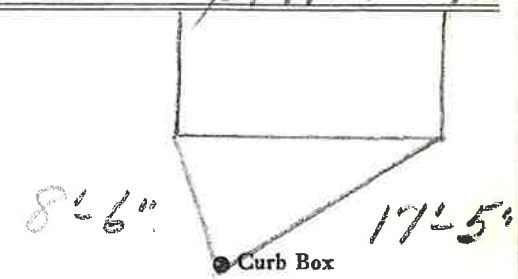

6" Main Elev. of Main at tap 5'

Gate at • Gate at •

● Curb Box

changed over from old
2" MAIN to NEW 6" MAIN
April-1974 ✓