


Labor and Materials

1	Copper } Connection	1/2		\$ 1.91
	Lead			
1	Curb } Cock Valve	3/4	in.	\$ 1.00
1	Service Box } Short 3 1/2 x 4 1/2			\$ 1.30
	Old returned			
10	Ft. 3/4 in. } Copper Galv. Iron } Pipe at			\$ 2.20
1	Nipples	1/2	in. at	\$.40
1	Bushings	1/2	in. at	\$.15
1	Red'g } Couplings	3/4 to 1/2	in. at	\$.15
	Inc'g			
	Union		in. at	\$.
	Meter		in. at	\$.
	Lbs. Br. Stone		at	\$.
	Lbs. Sand		at	\$.
	Bags Cement		at	\$.
	Paving Brick } Mack Red Asphalt		at	\$.
	Lead Joints		at	\$.
	Leadite Joints		at	\$.
2	Hrs. Foreman	6.25		\$ 1.25
	Hrs. Common Labor			\$.
7	Hrs. Common Labor	4.00		\$ 2.85
	Hrs. Mason			\$.
	Hrs. Mason's Helper			\$.
	Hrs. Compressor			\$.
	Compensation Ins.			\$.12
	Trucking			\$ 1.00
	Builders' Use of Water			\$.
Total				\$ 12.03

Labor and Material Report

June 4 1926

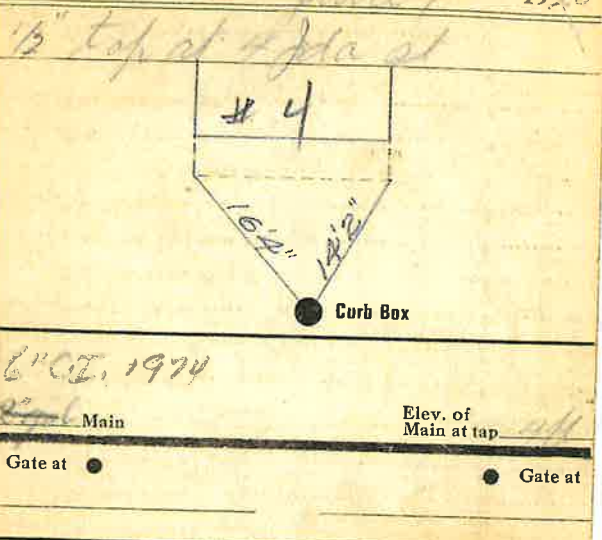

6" CI, 1974



● Curb Box

changed over from
old 2" MAIN to New
6" MAIN - April - 1974